




Legend	
*	Required Field
	Editable Field
	Read Only Field

## Design Change - E-Mail Initiated (DCE)

Project:	I-69 Section 5 Project
Process:	Design Change - E-Mail Initiated
* Subject:	FDC 905 Level 1 - Section corner points
Due Date:	10 days after submitting document

* DC Date:	11.09.2018
* Requested DLZ Response Date:	11.16.2018
* Requested INDOT Response Date:	11.19.2018
* High Priority Activity Form Used?:	No
Type of Design Change:	FDC
FDC:	Level 1
Design Unit: Tree Clearing - 3B:	-- Please select an option --
Design Unit: 4A-1 - 5C:	Design Unit 4A-1 - Mainline Rehab 215+13 to 504+00. GradingPaving
Design Unit: 6:	-- Please select an option --
* FDC/NDC Number:	905
* Drawings Affected:	Various

* Question/Issue:	Some of the previously existing section corner points were destroyed during the construction of I-69.
* Proposed Solution:	Please update the plans to show replacement of these points.
* EOR Response:	See attached markups.
Responsible Engineer Signature & Date:	 11/14/2018
Lead Engineer Signature & Date:	(For Level 3 FDCs and NDCs)
Design Quality Manager Signature & Date:	(For Level 3 FDCs and NDCs)


#### Comments

**Please Note:**

This document will initiate a Design Change - E-Mail Initiated (DCE) on the I-69 Section 5 Project project. Fill out this form and save the document to your computer. Attach and e-mail the document to **inbox@workflow.e-builder.net**. You will receive a response e-mail from e-Builder to let you know the status of your submission. If successful, the message will contain the e-Builder document number that was created. If there were any problems with your submission, the message will list the errors and actions required to resolve them.

Plotted By: JMD 01-Sep-15 10:08:21


DATE	REVISION

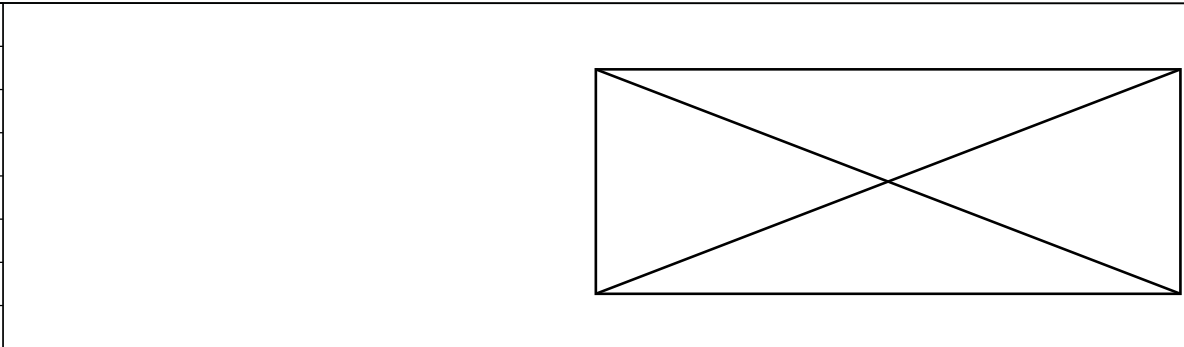

RECOMMENDED FOR APPROVAL	<i>Jeff Callioff</i>	01/28/2016
DESIGNED: CL	DRAWN: PMG	09/15
CHECKED: APF	CHECKED: JGJ	09/15

INDIANA DEPARTMENT OF TRANSPORTATION
GEOMETRIC CONTROL STA 215+13 TO STA 245+00 LINE "A"


SCALE	BRIDGE FILE	
1"=100'	N/A	
VERTICAL SCALE	DESIGNATION	
NONE	1297885	
SURVEY BOOK	DWG NO.	SHEET
ELECTRONIC / AERIAL	RD-GL-01	10 of 213
CONTRACT	PROJECT	
	1297885	

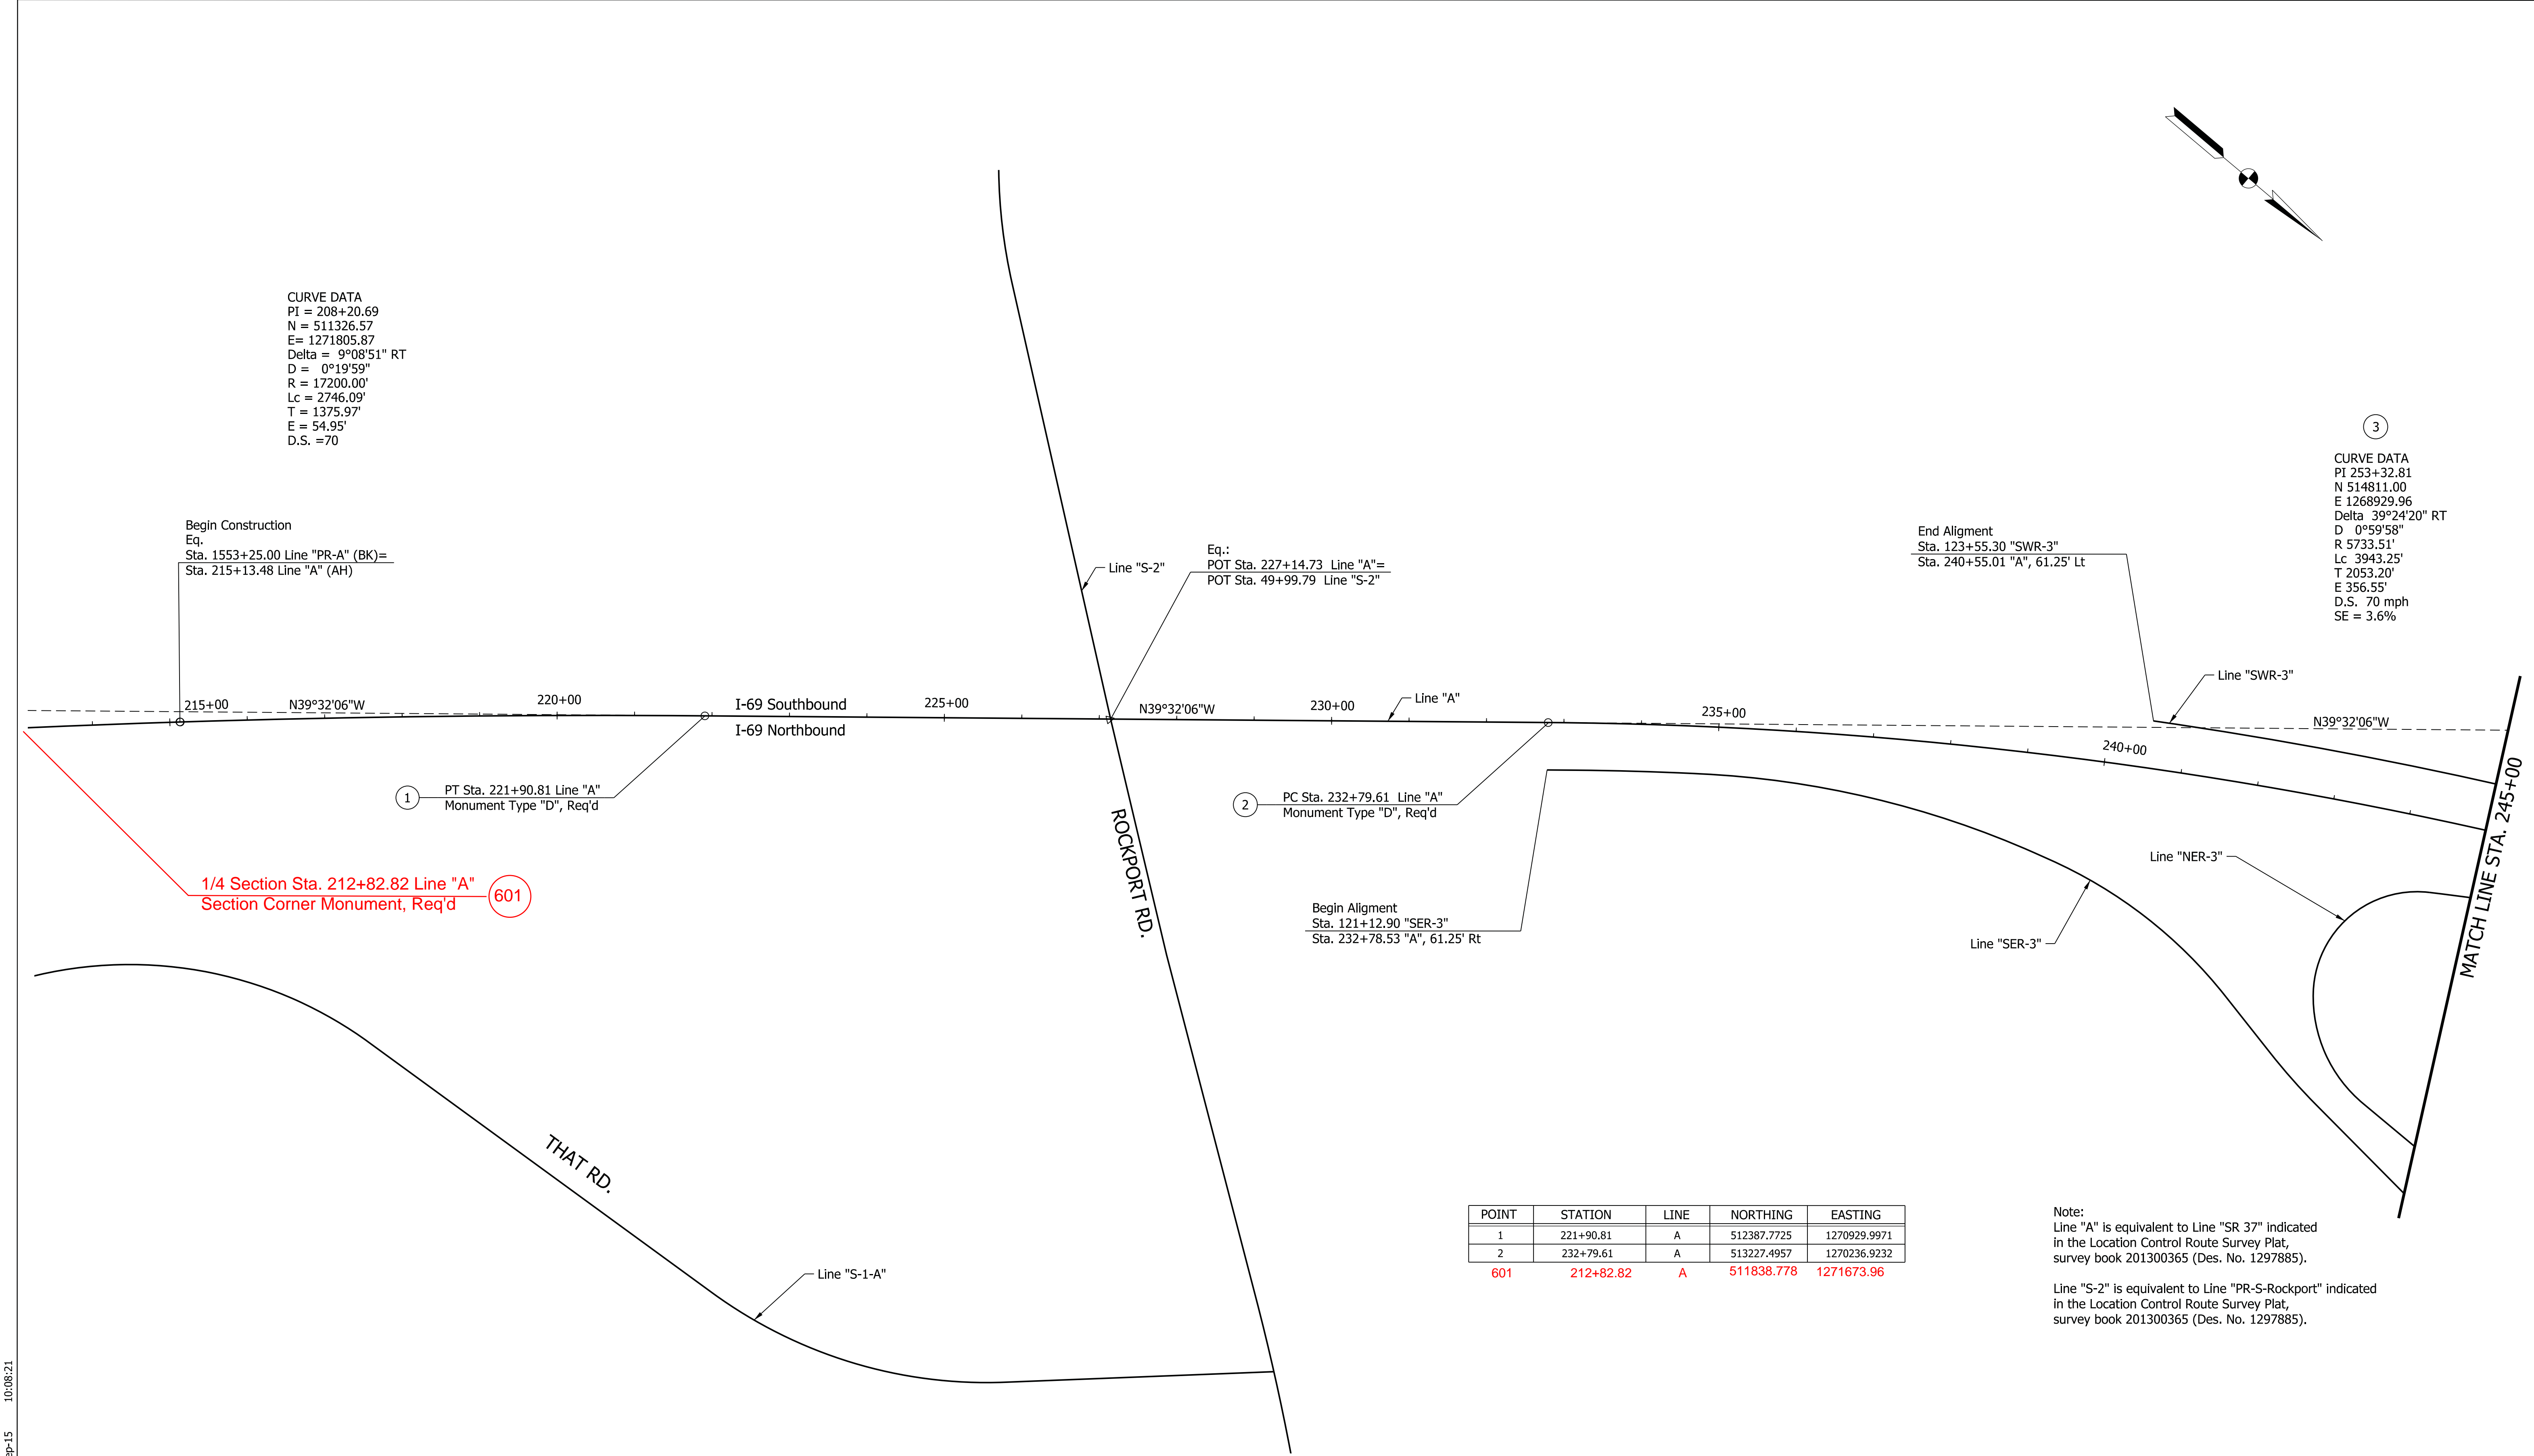

POINT	STATION	LINE	NORTHING	EASTING
1	221+90.81	A	512387.7725	1270929.9971
2	232+79.61	A	513227.4957	1270236.9232
601	212+82.82	A	511838.778	1271673.96

Note:  
Line "A" is equivalent to Line "SR 37" indicated in the Location Control Route Survey Plat, survey book 201300365 (Des. No. 1297885).

Line "S-2" is equivalent to Line "PR-S-Rockport" indicated in the Location Control Route Survey Plat, survey book 201300365 (Des. No. 1297885).

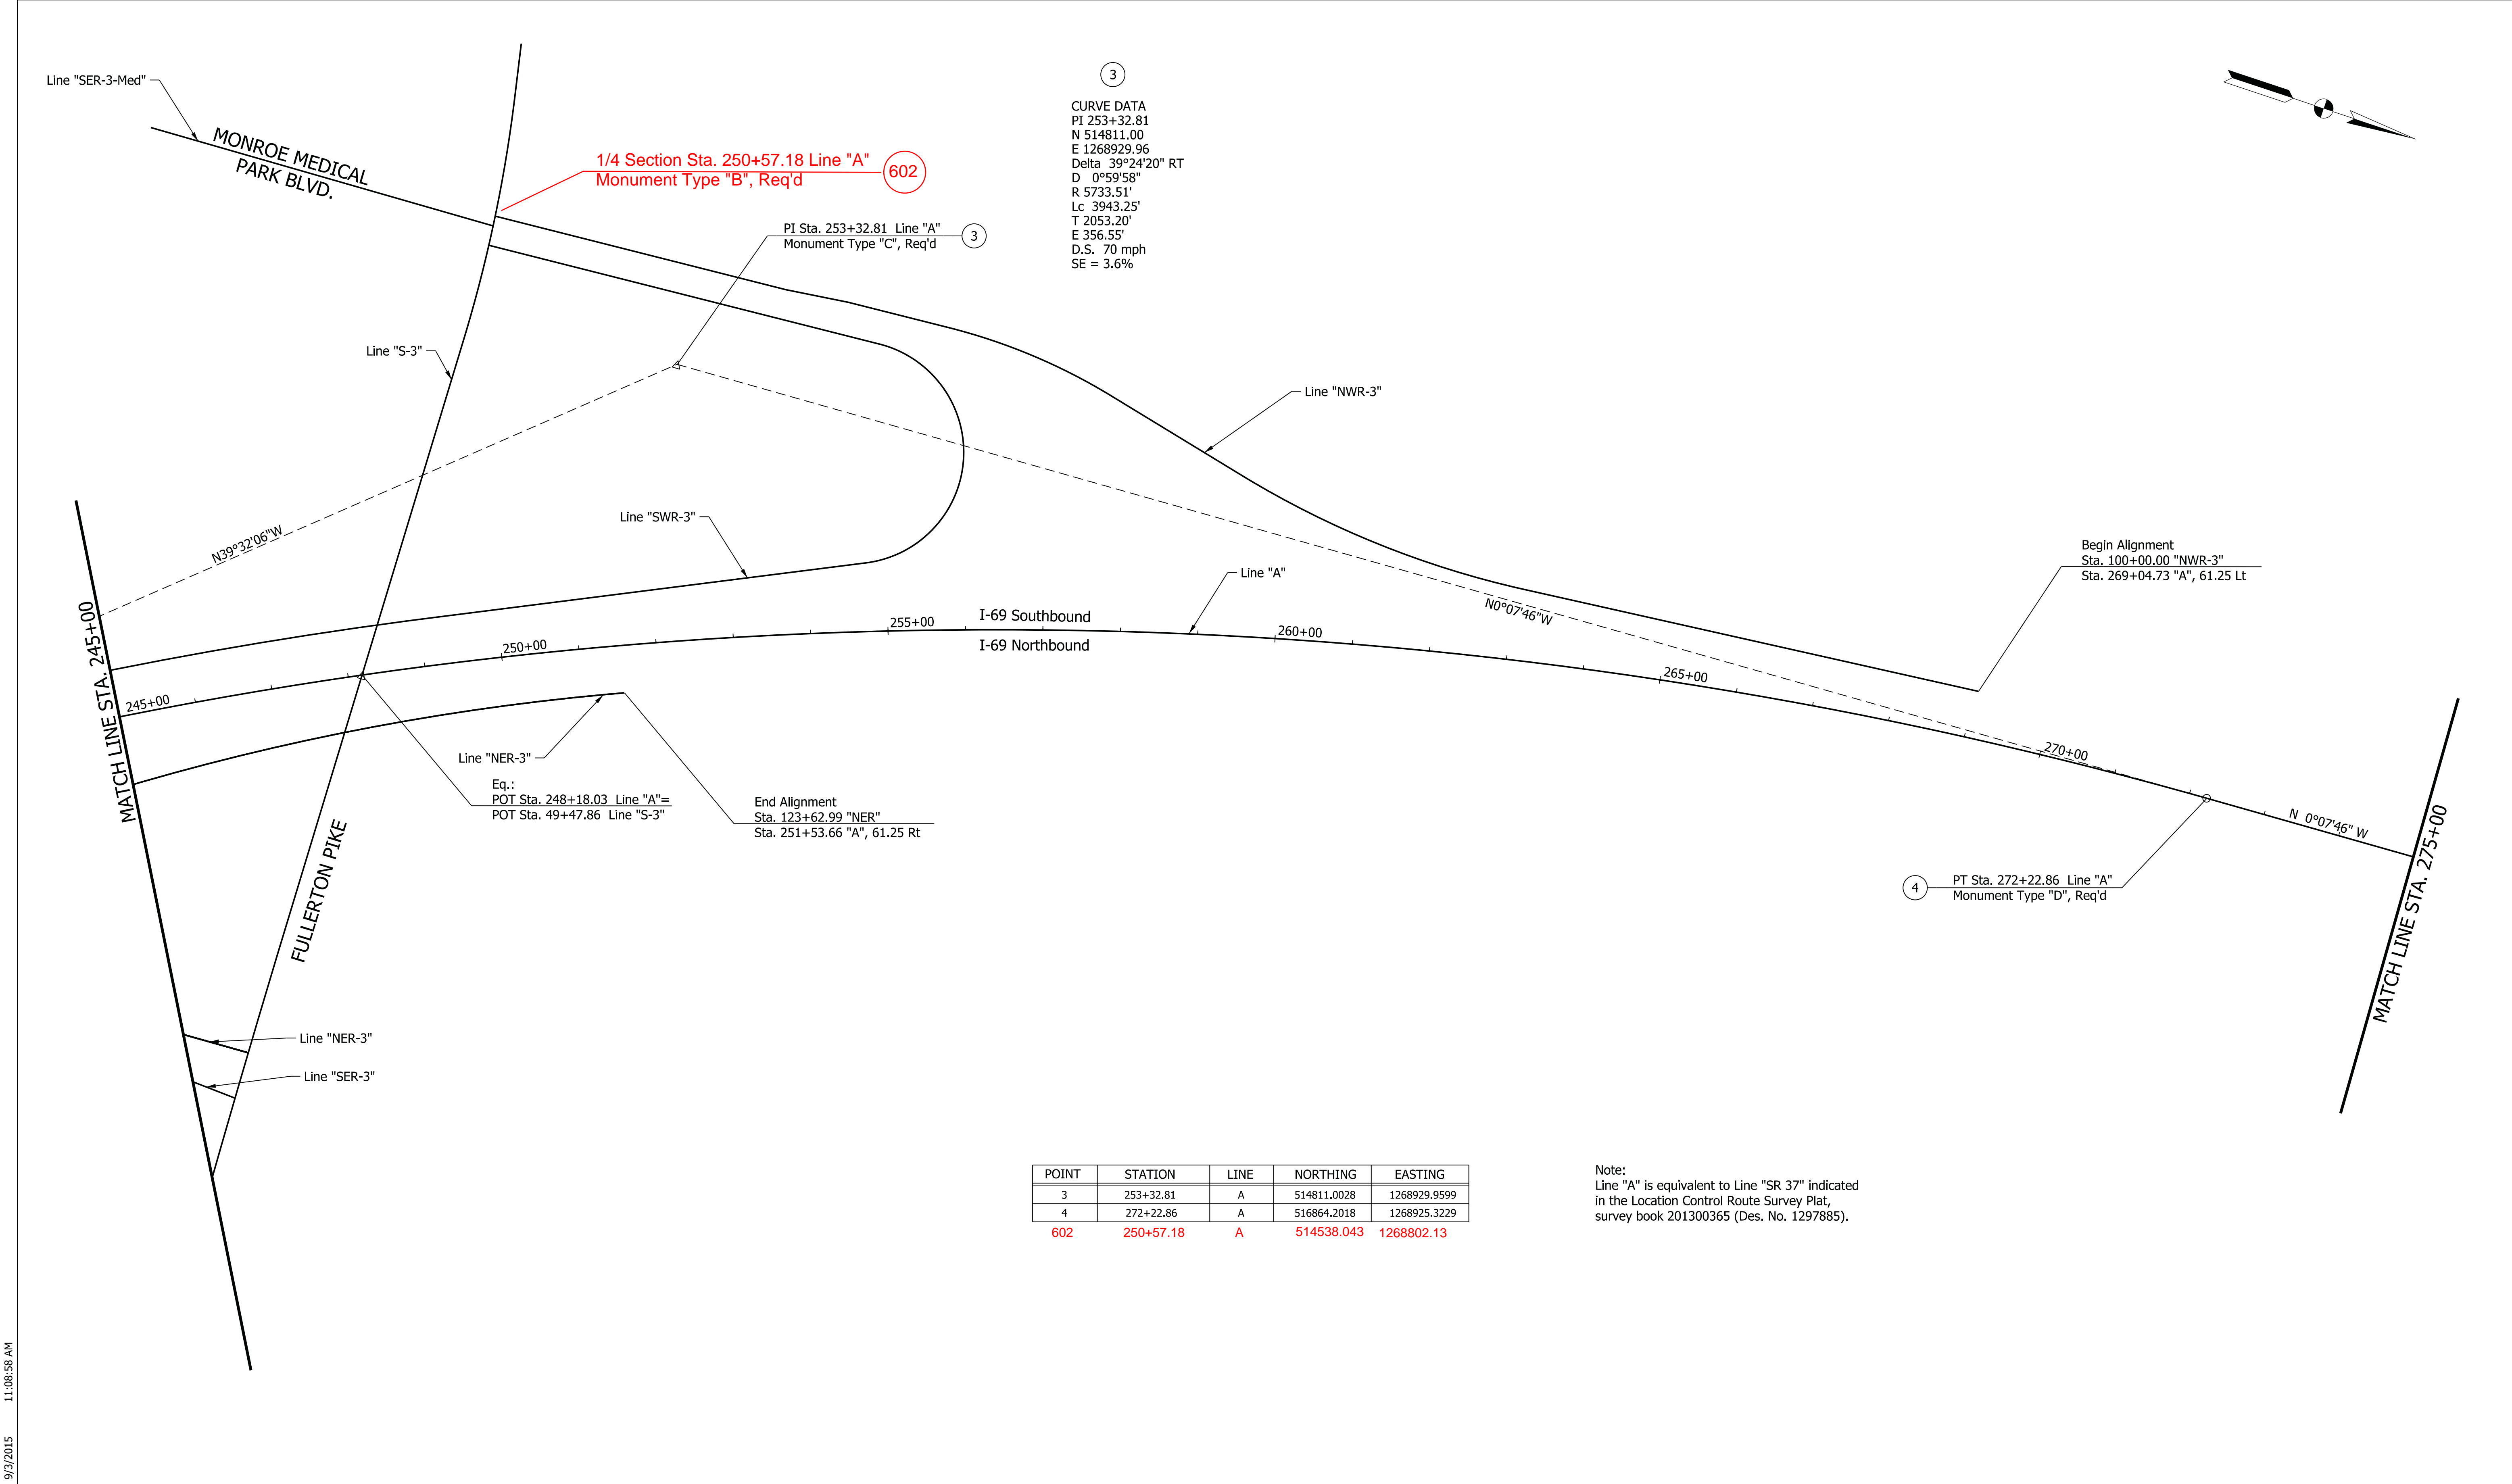

POINT	STATION	LINE	NORTHING	EASTING
3	253+32.81	A	514811.0028	1268929.9599
4	272+22.86	A	516864.2018	1268925.3229
602	250+57.18	A	514538.043	1268802.13

Note:  
Line "A" is equivalent to Line "SR 37" indicated  
in the Location Control Route Survey Plat,  
survey book 201300365 (Des. No. 1297885).

Plotted By: user

9/3/2015

11:08:58 AM

DATE	REVISION

JEFFREY LYLE CALICOTT

REGISTERED

NO. 11400561

STATE OF INDIANA

PROFESSIONAL ENGINEER

RECOMMENDED FOR APPROVAL

*Jeff Callcott*

01/28/2016

DESIGN ENGINEER

DATE

DESIGNED: CL 09/15

DRAWN: PMG 09/15

CHECKED: APF 09/15

CHECKED: JGJ 09/15

INDIANA

DEPARTMENT OF TRANSPORTATION


GEOMETRIC CONTROL

STA 245+00 TO STA 275+00 LINE "A"

SCALE	BRIDGE FILE	
1"=100'	N/A	
	DESIGNATION	
	1297885	
SURVEY BOOK	DWG NO.	SHEET
ELECTRONIC / AERIAL	RD-GL-02	11 of 213
CONTRACT	PROJECT	1297885

9/3/2015 11:11:27 AM  
Plotted By: user


DATE	REVISION

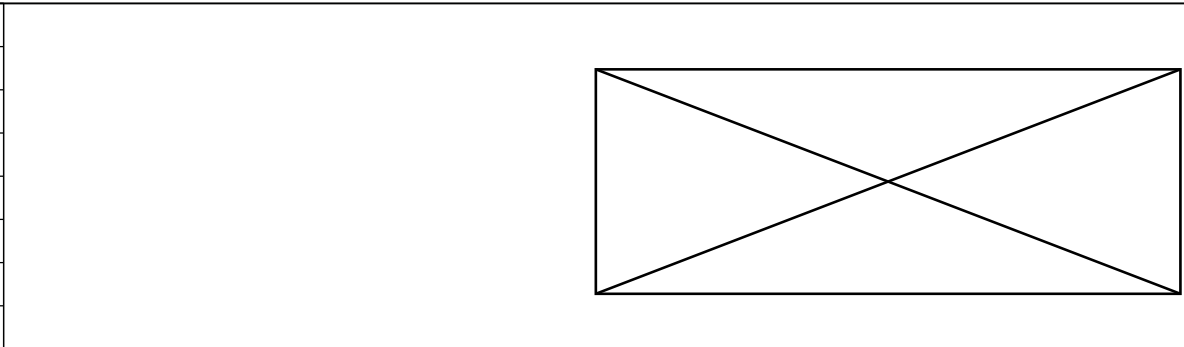

RECOMMENDED FOR APPROVAL	<i>Jeff Callicott</i>	01/28/2016
DESIGNED: CL 09/15	DRAWN: PMG 09/15	DATE
CHECKED: APF 09/15	CHECKED: JGJ 09/15	DESIGN ENGINEER

INDIANA DEPARTMENT OF TRANSPORTATION
GEOMETRIC CONTROL STA 275+00 TO STA 305+00 LINE "A"



SCALE	BRIDGE FILE	
1"=100'	N/A	
	DESIGNATION	
	1297885	
SURVEY BOOK	DWG NO.	SHEET
ELECTRONIC / AERIAL	RD-GL-03	12 of 213
CONTRACT	PROJECT	
	1297885	

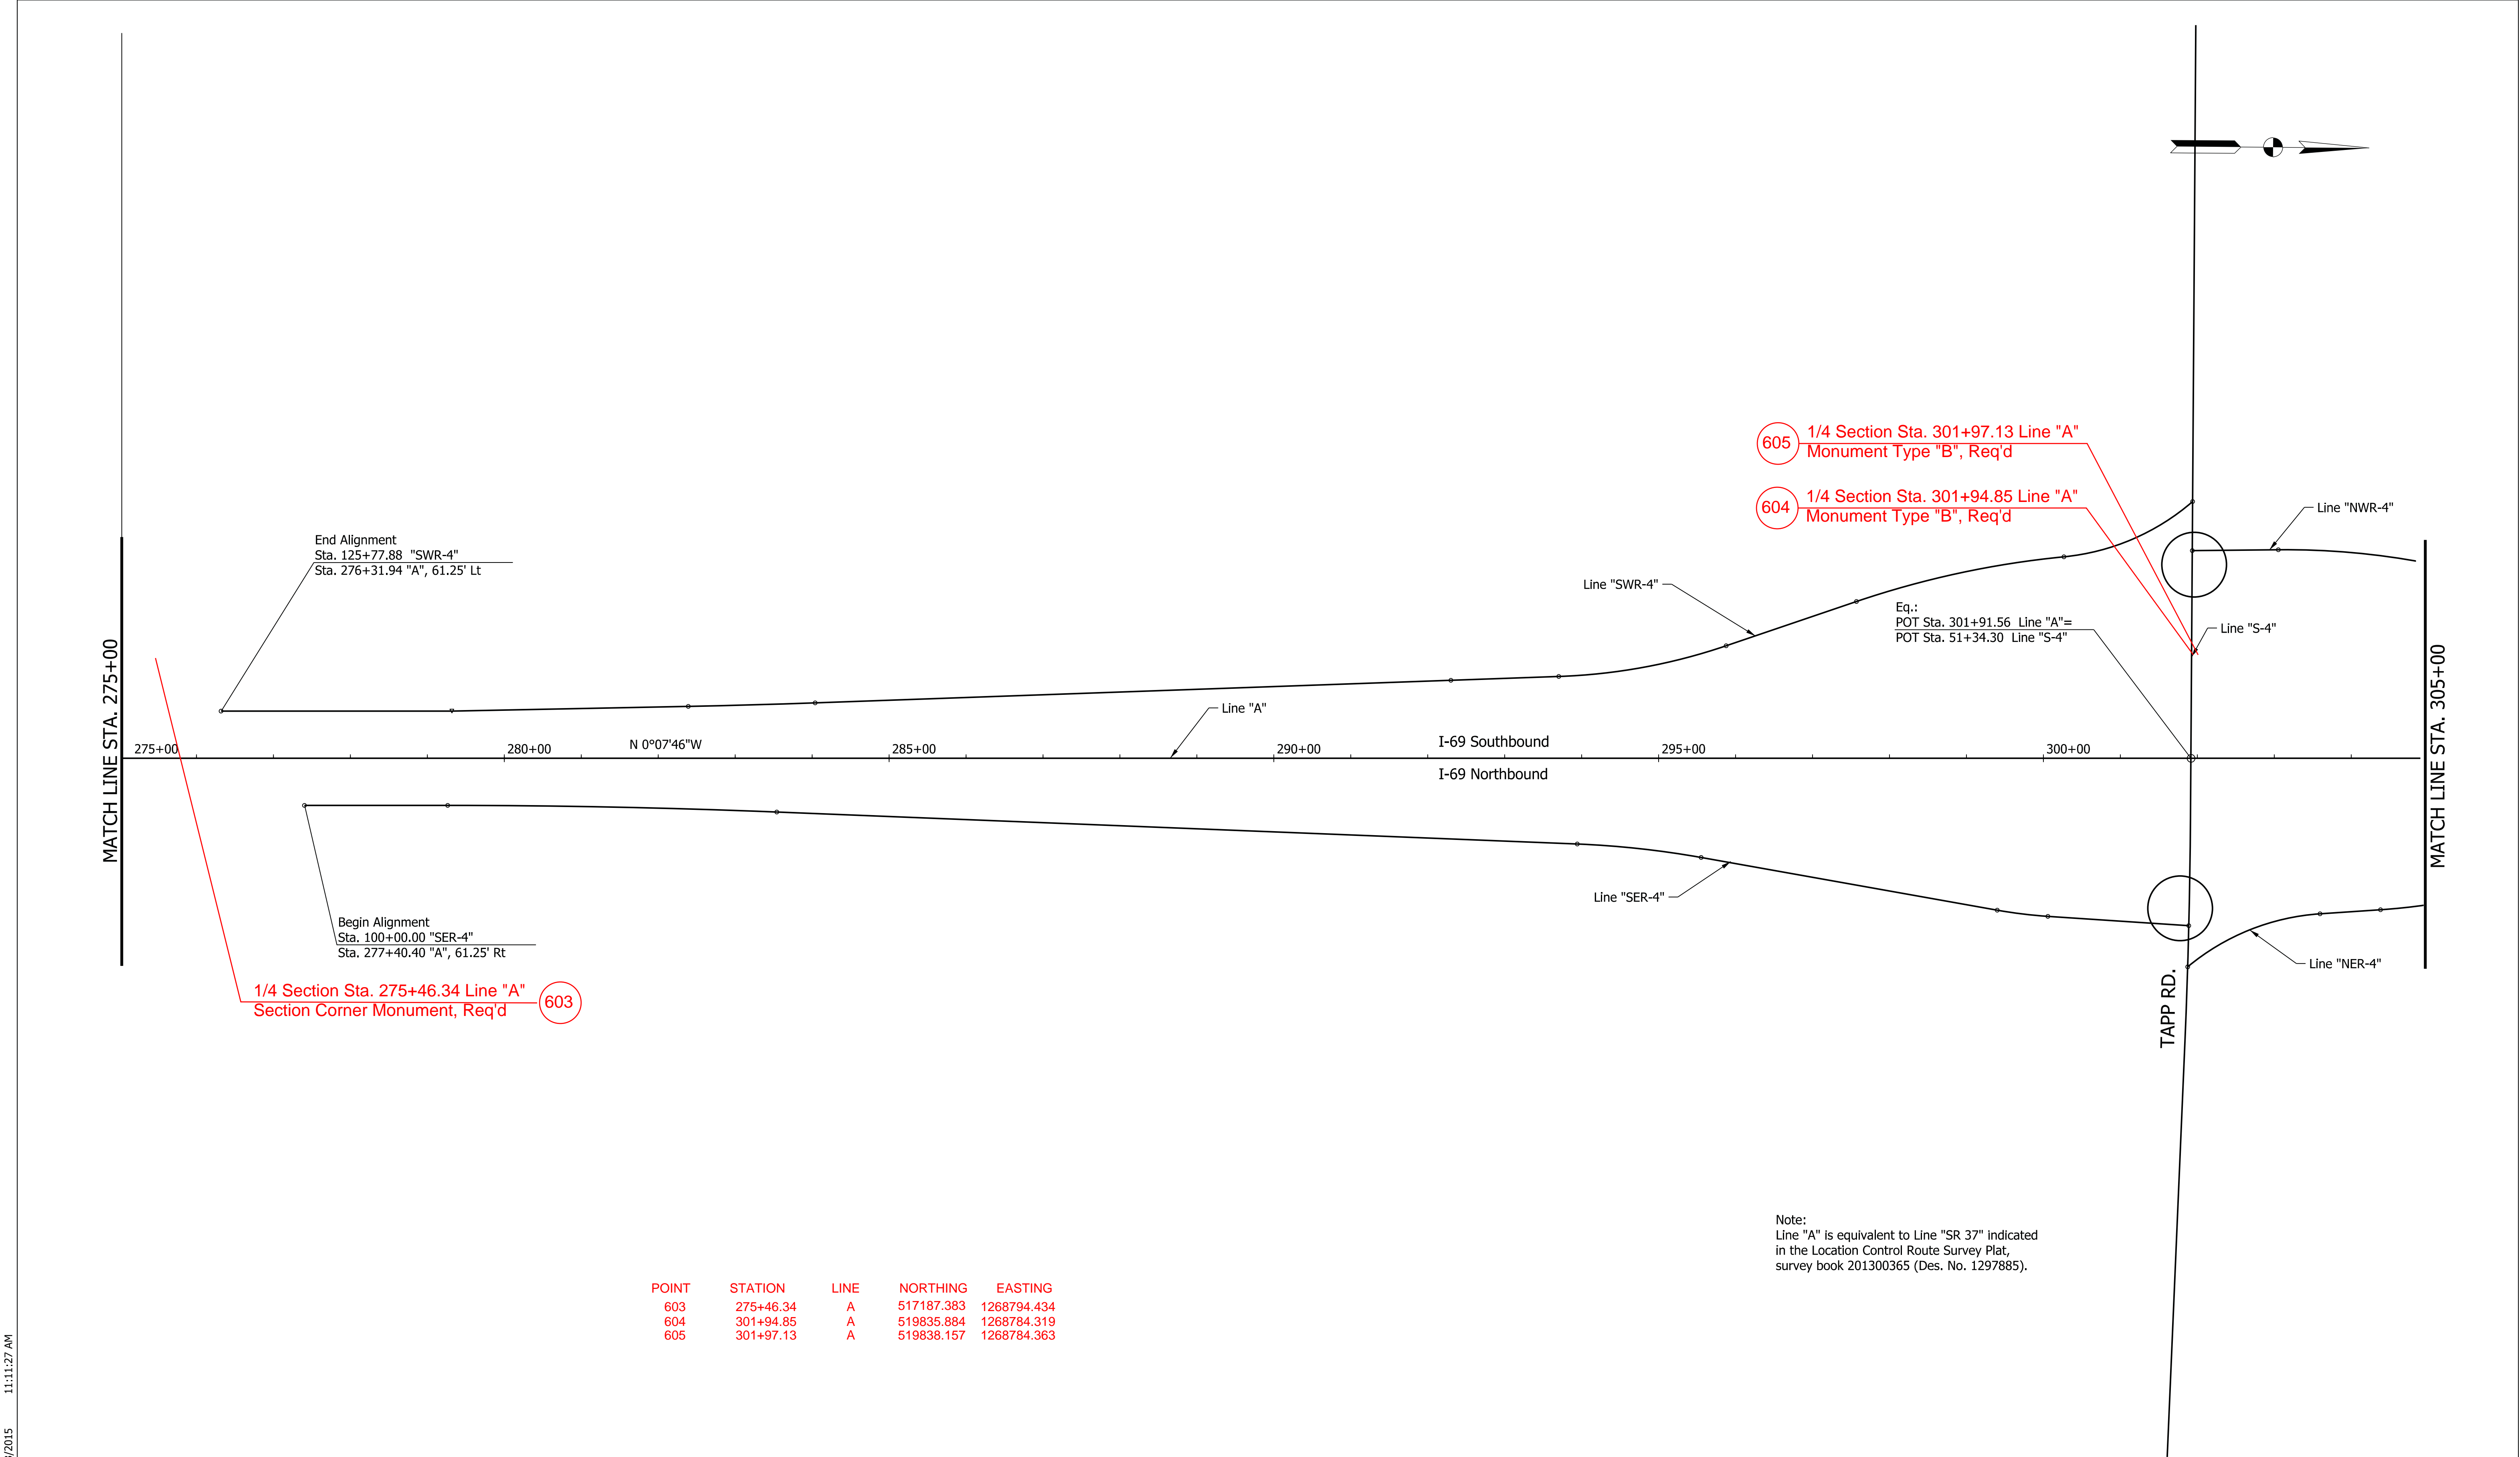

POINT	STATION	LINE	NORTHING	EASTING
603	275+46.34	A	517187.383	1268794.434
604	301+94.85	A	519835.884	1268784.319
605	301+97.13	A	519838.157	1268784.363

08/02/2016 14:42:04  
Plotted By: GAD


DATE	REVISION

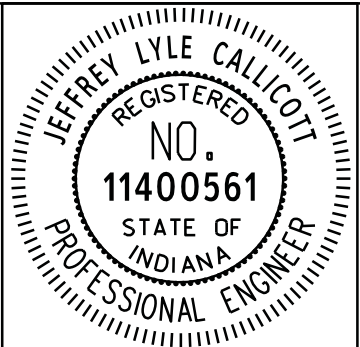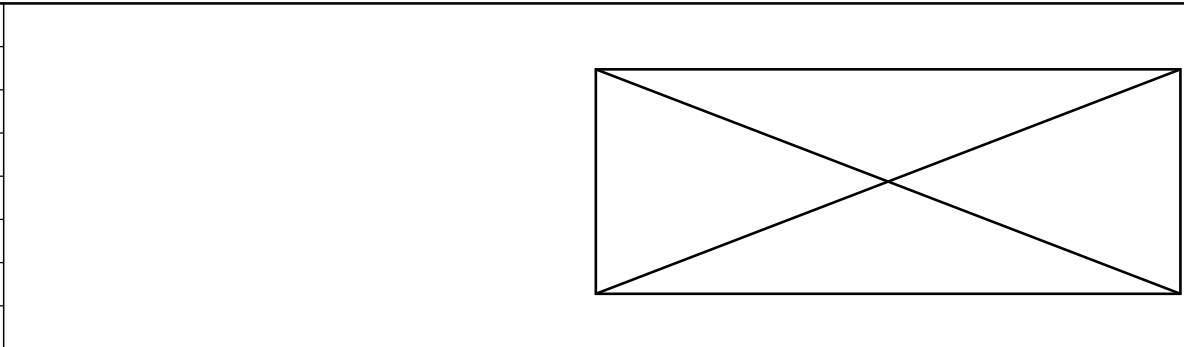

RECOMMENDED FOR APPROVAL	<i>Jeff Calcott</i>	02/16/2016
DESIGNED: CL 09/15	DRAWN: PMG 09/15	DATE
CHECKED: APF 09/15	CHECKED: JGJ 09/15	


INDIANA DEPARTMENT OF TRANSPORTATION
GEOMETRIC CONTROL STA 335+00 TO STA 365+00 LINE "A"

SCALE	BRIDGE FILE	
1"=100'	N/A	
	DESIGNATION	
	1297885	
SURVEY BOOK	DWG NO.	SHEET
ELECTRONIC / AERIAL	RD-GL-05	14 of 213
CONTRACT	PROJECT	
	1297885	


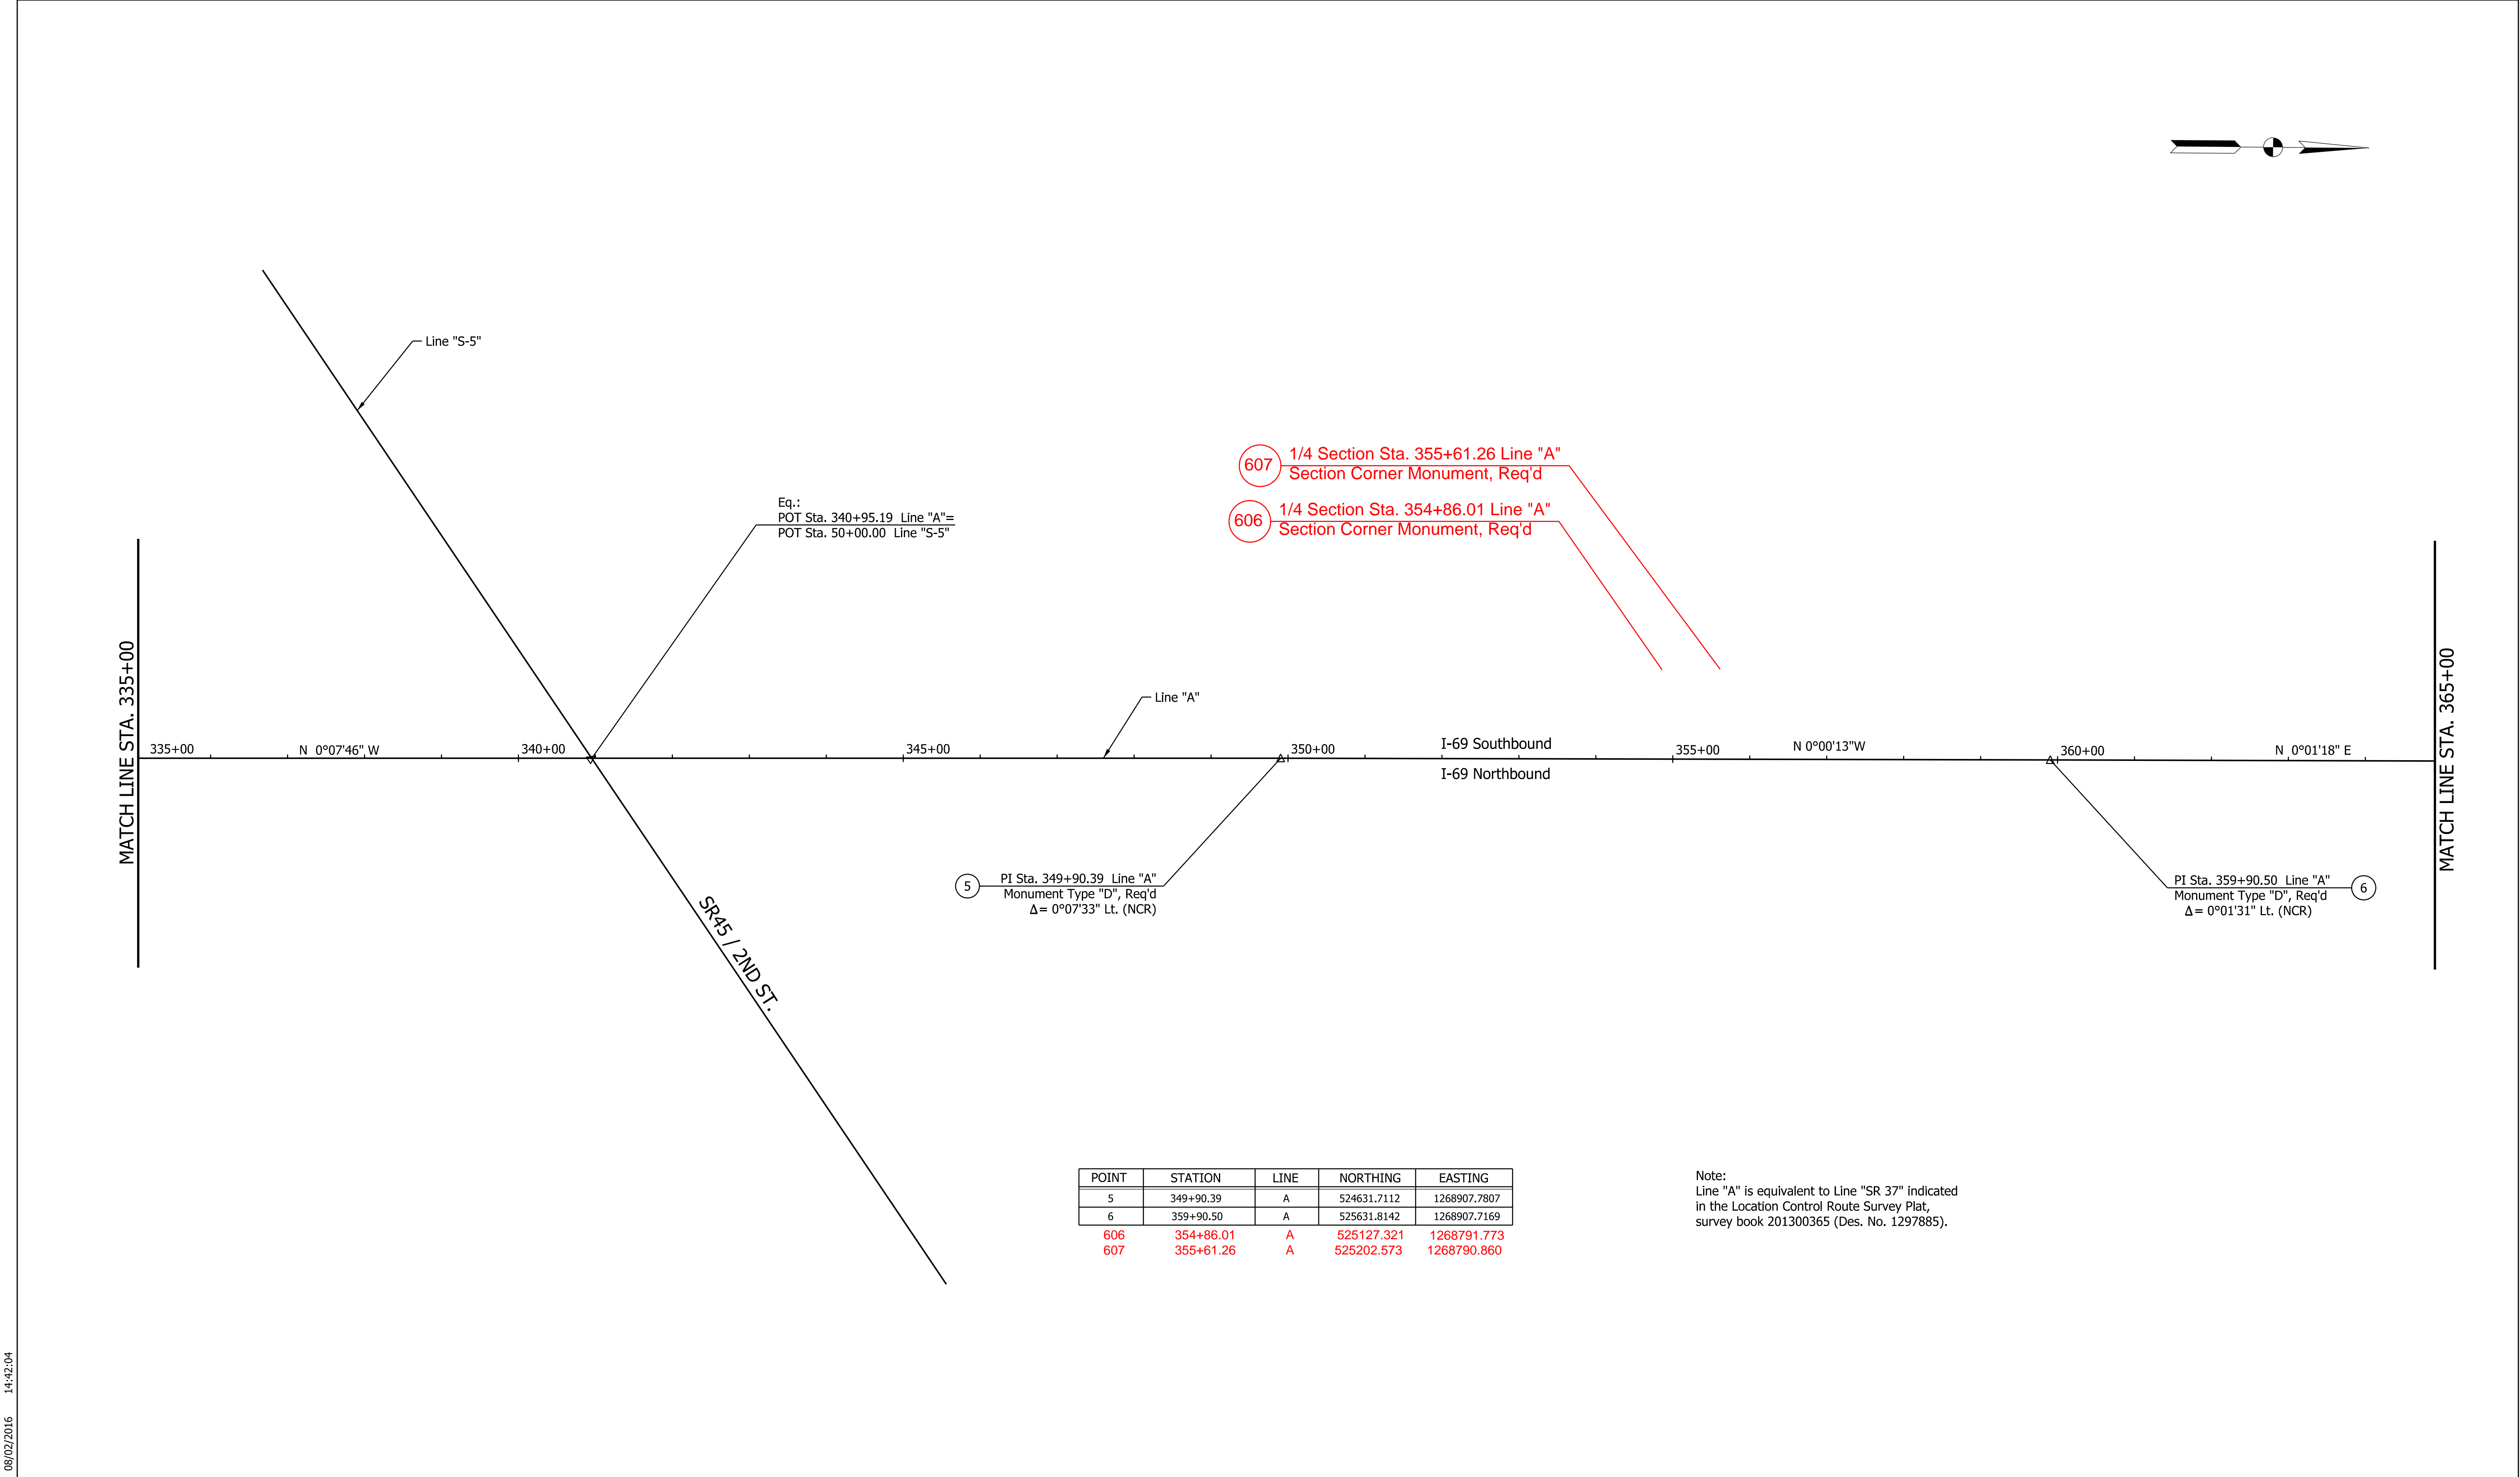


POINT	STATION	LINE	NORTHING	EASTING
5	349+90.39	A	524631.7112	1268907.7807
6	359+90.50	A	525631.8142	1268907.7169
606	354+86.01	A	525127.321	1268791.773
607	355+61.26	A	525202.573	1268790.860

9/3/2015 11:13:50 AM  
Plotted By: user

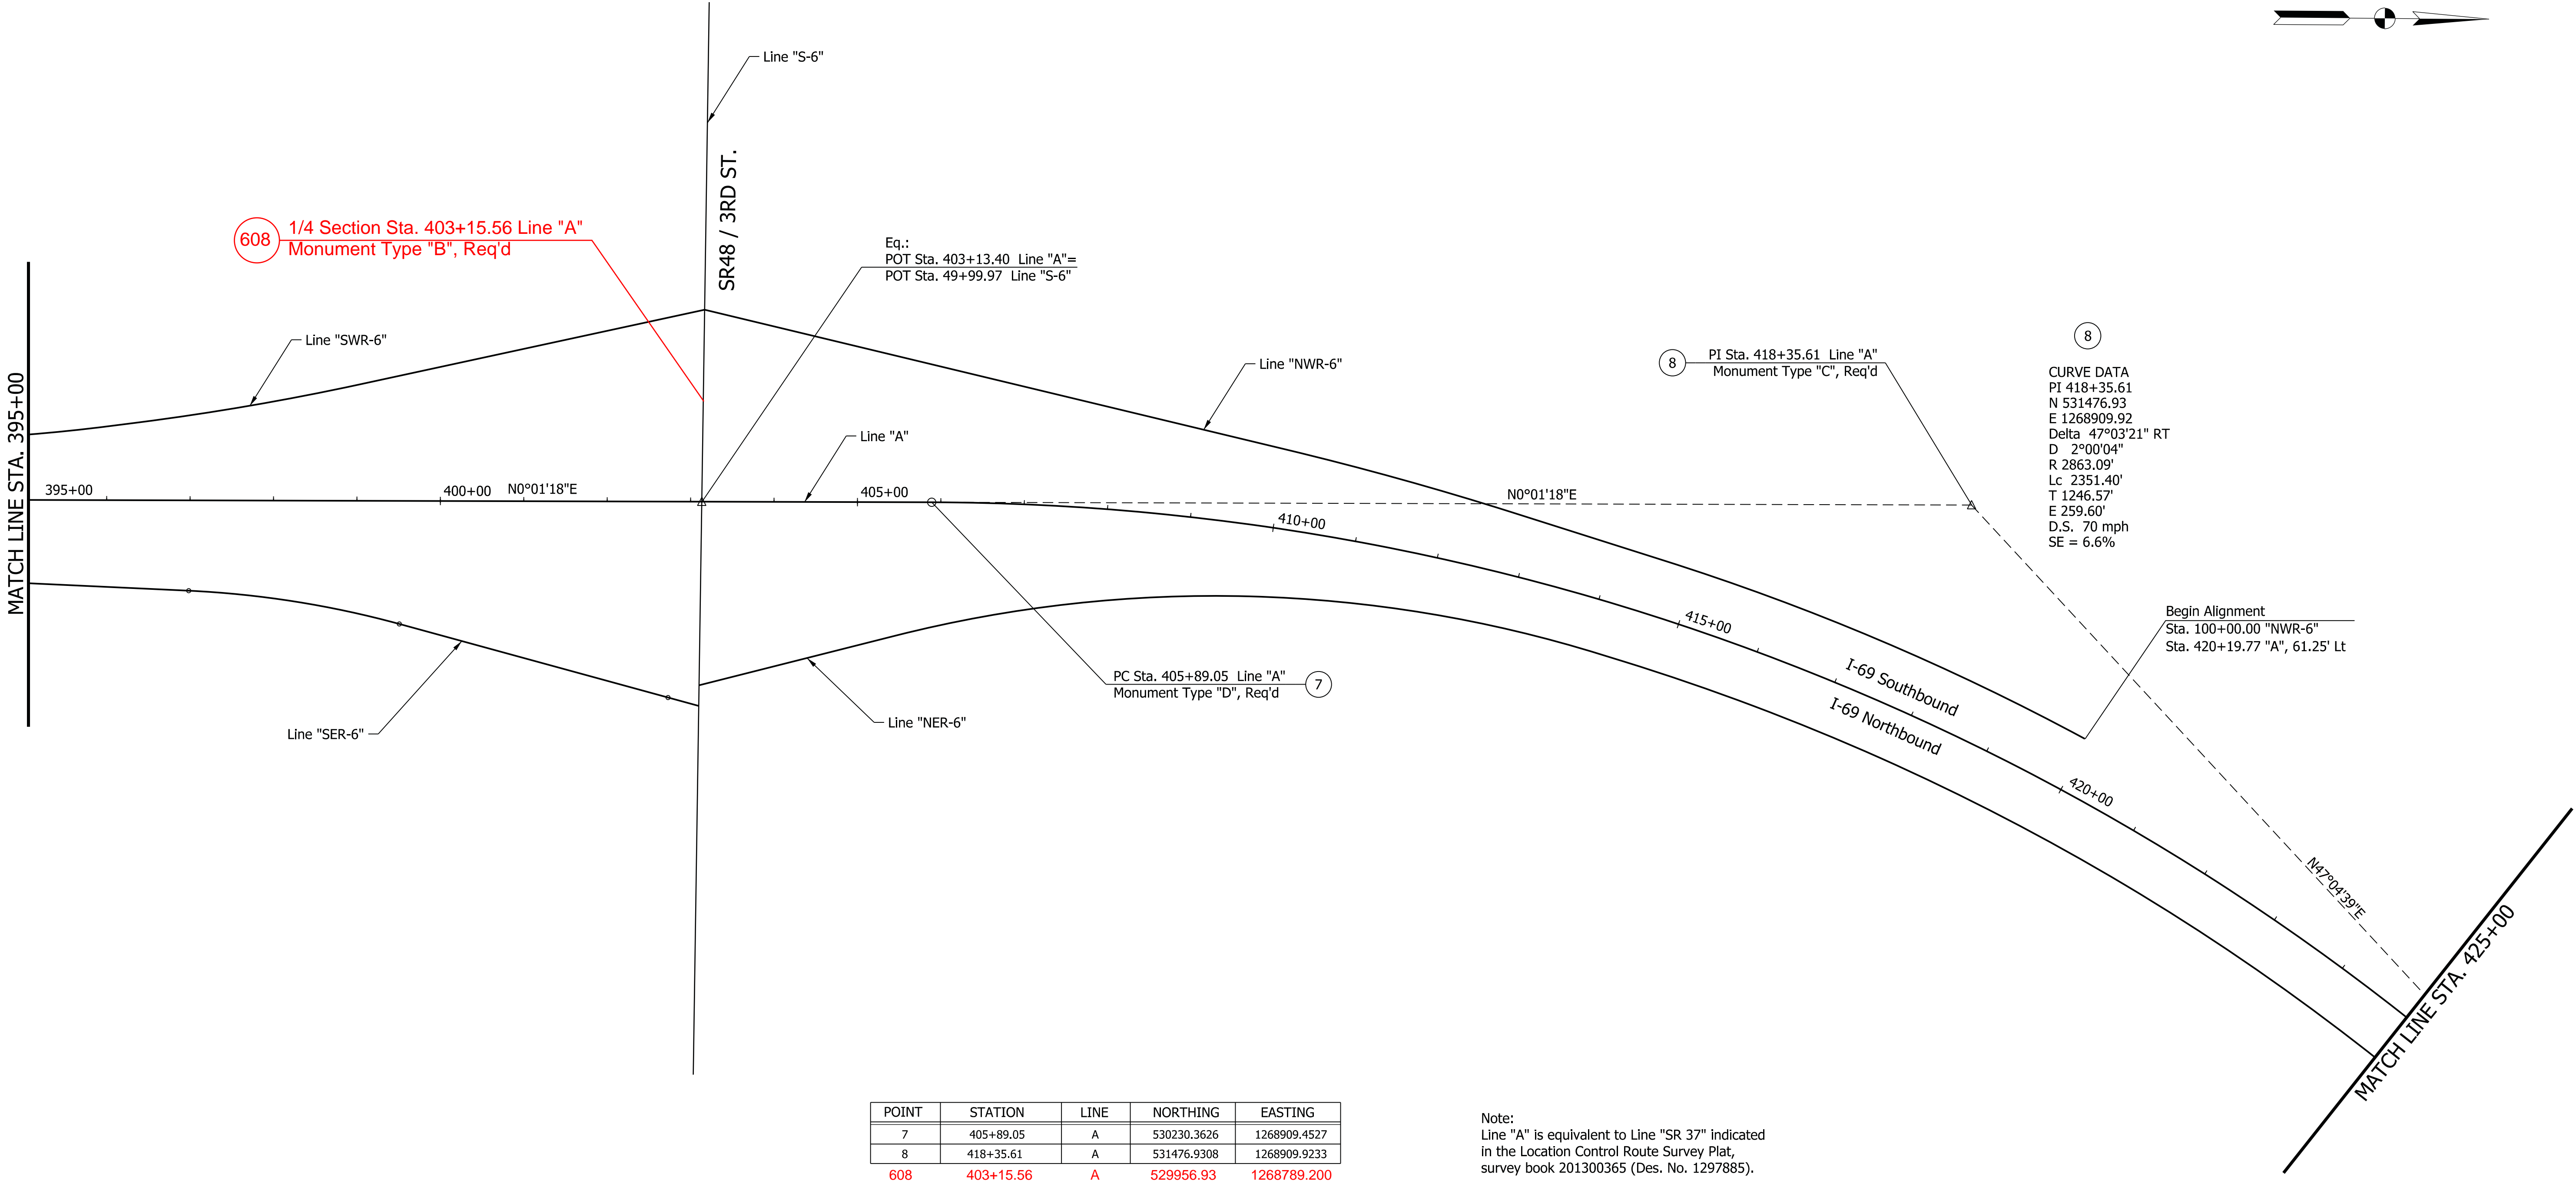

DATE	REVISION

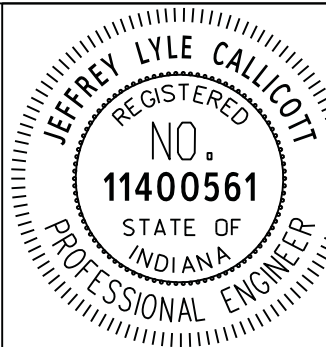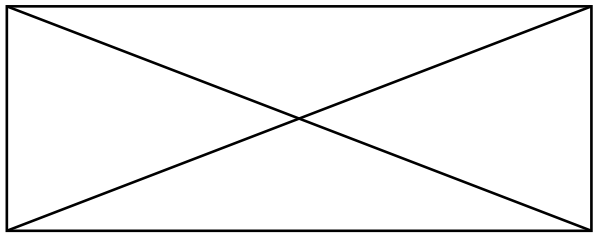


RECOMMENDED FOR APPROVAL	<i>Jeff Callicott</i>	01/28/2016
DESIGNED: CL	09/15	DRAWN: PMG 09/15
CHECKED: APF	09/15	CHECKED: JGJ 09/15

INDIANA DEPARTMENT OF TRANSPORTATION
GEOMETRIC CONTROL STA 395+00 TO STA 425+00 LINE "A"

SCALE 1"=100'	BRIDGE FILE N/A
SURVEY BOOK ELECTRONIC / AERIAL	DESIGNATION 1297885
DWG NO. RD-GL-07	SHEET 16 of 213
CONTRACT	PROJECT 1297885

9/2/2015 5:25:17 PM  
Plotted By: PMA

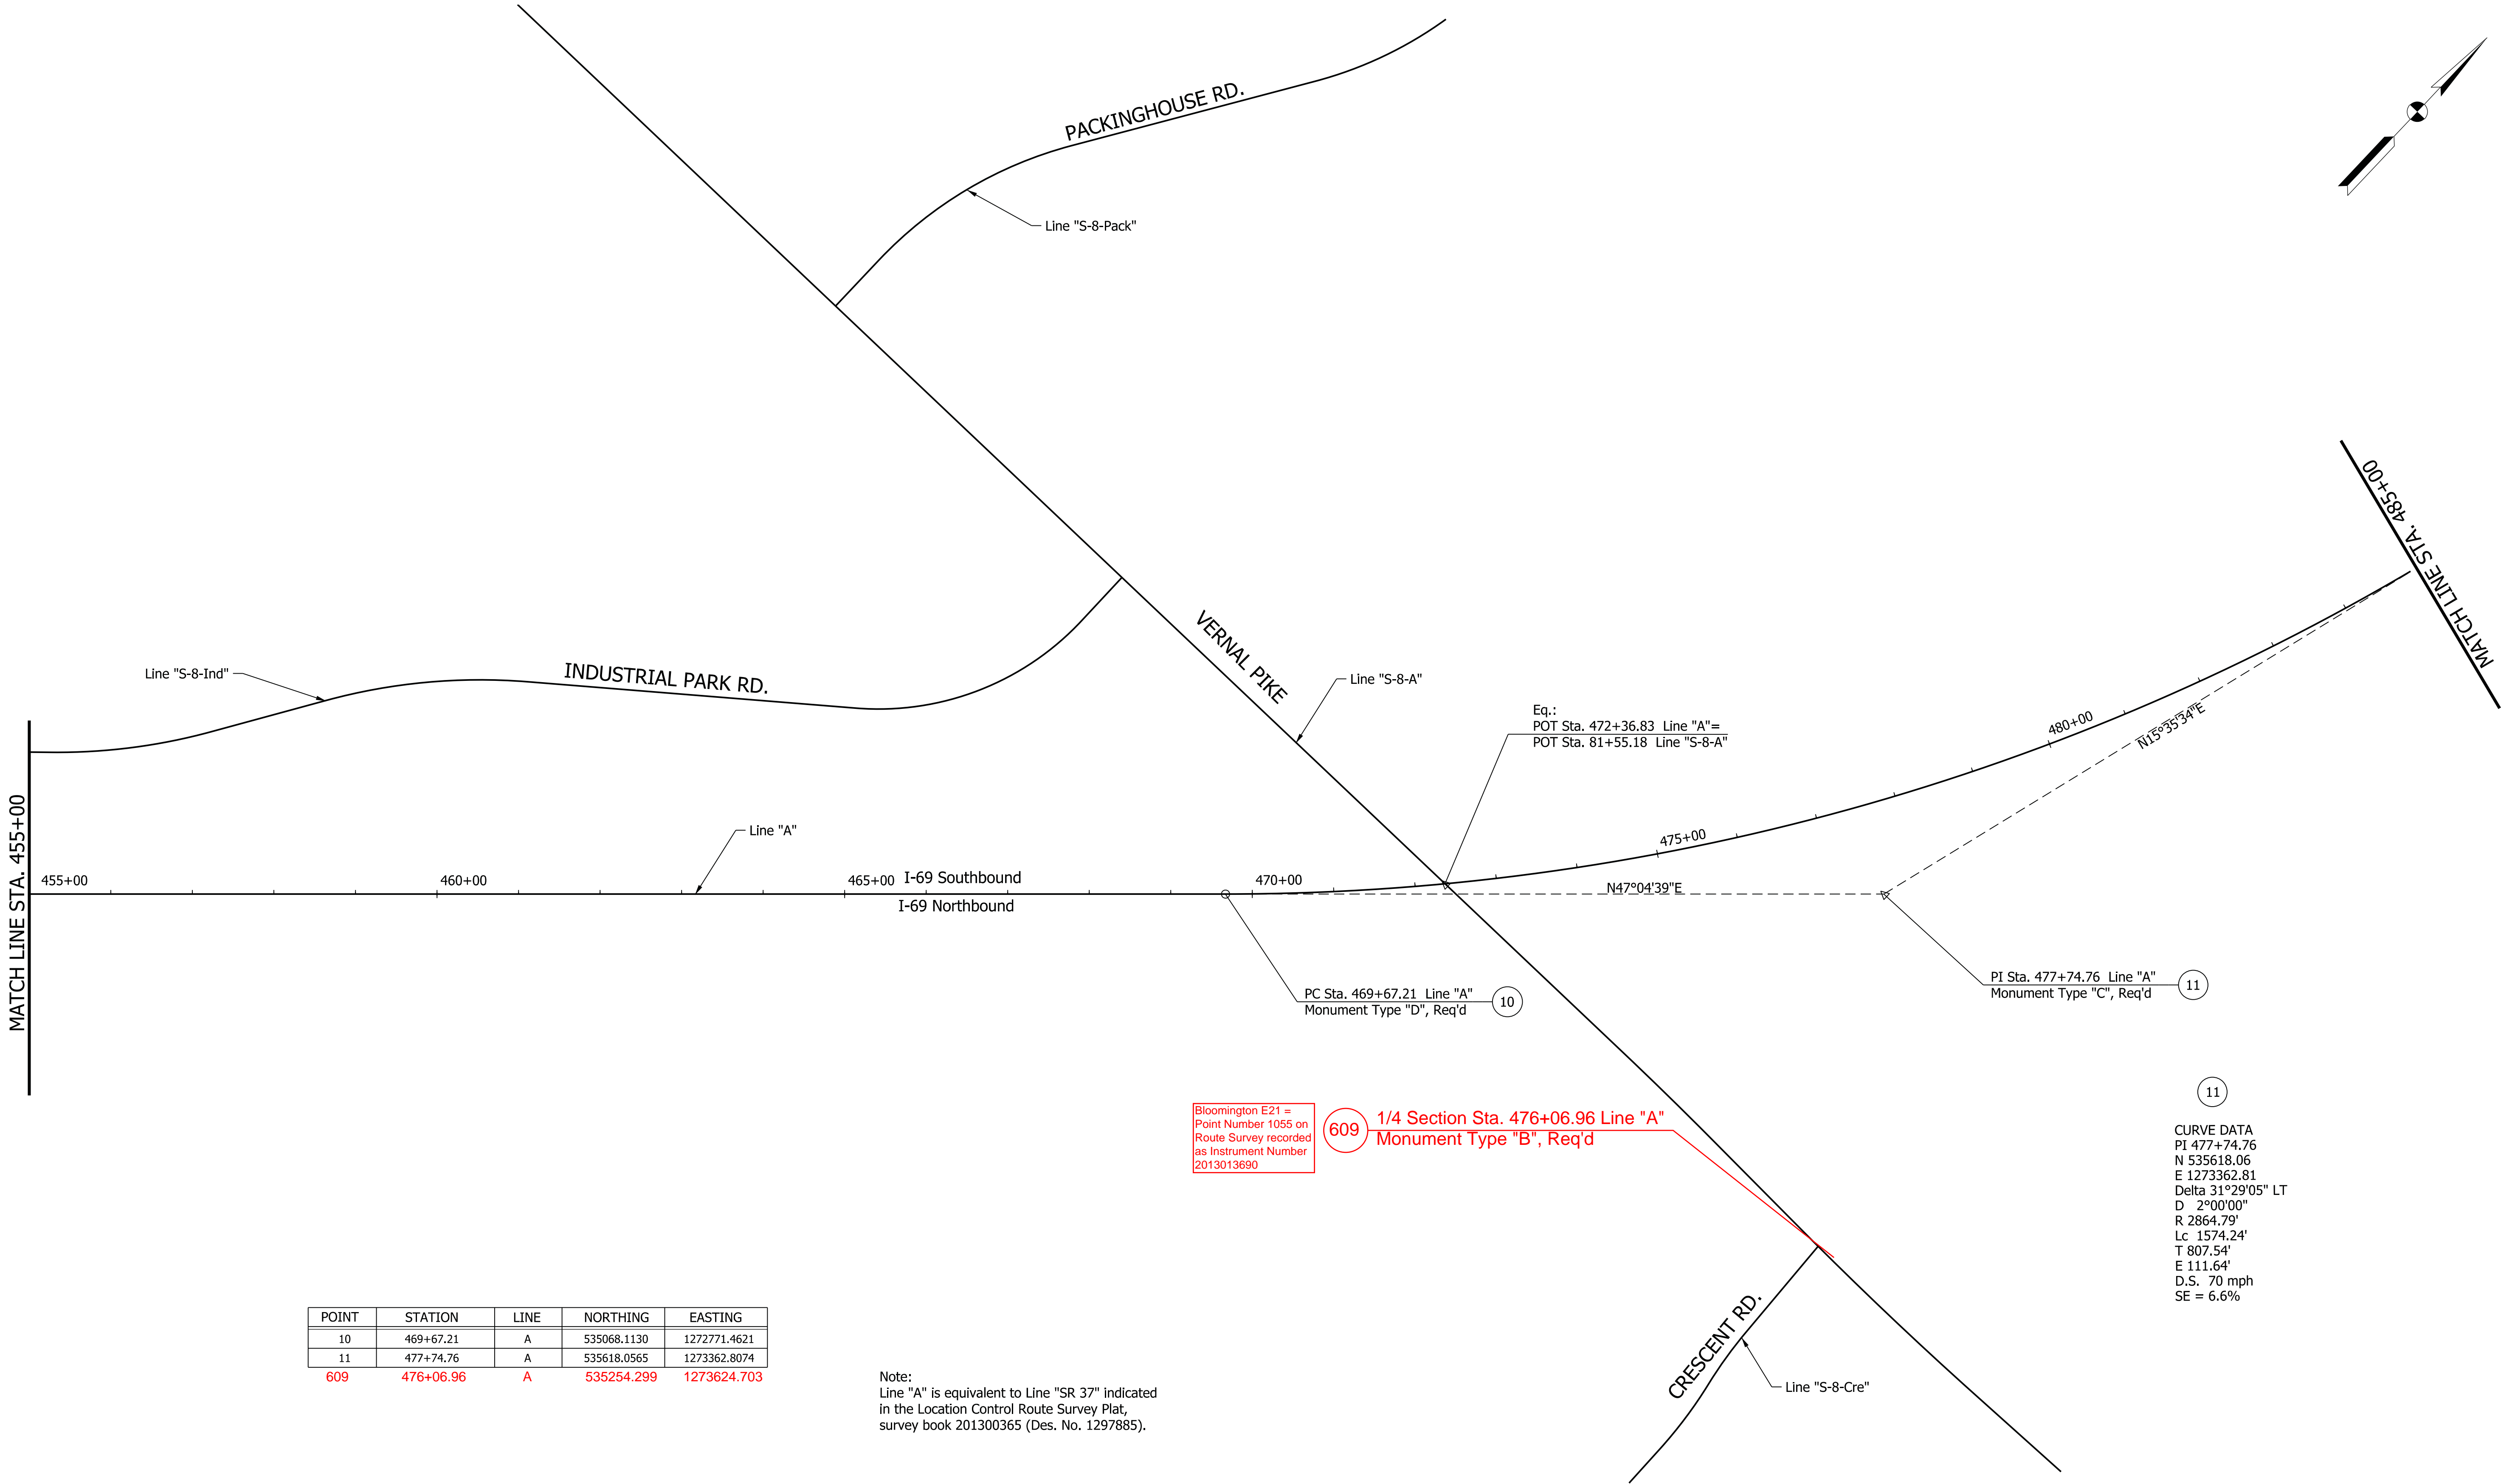

POINT	STATION	LINE	NORTHING	EASTING
10	469+67.21	A	535068.1130	1272771.4621
11	477+74.76	A	535618.0565	1273362.8074
609	476+06.96	A	535254.299	1273624.703


Note:  
Line "A" is equivalent to Line "SR 37" indicated  
in the Location Control Route Survey Plat,  
survey book 201300365 (Des. No. 1297885).

Bloomington E21 =  
Point Number 1055 on  
Route Survey recorded  
as Instrument Number  
2013013690

609 1/4 Section Sta. 476+06.96 Line "A"  
Monument Type "B", Req'd

11  
CURVE DATA  
PI 477+74.76  
N 535618.06  
E 1273362.81  
Delta 31°29'05" LT  
D 2°00'00"  
R 2864.79'  
Lc 1574.24'  
T 807.54'  
E 111.64'  
D.S. 70 mph  
SE = 6.6%

DATE	REVISION

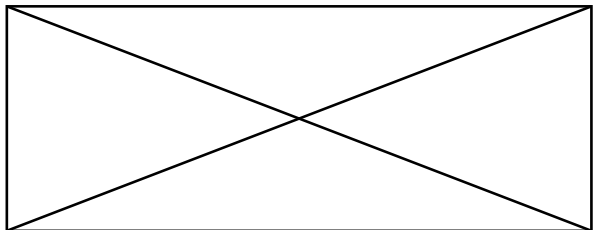


RECOMMENDED FOR APPROVAL	<i>Jeff Callcott</i>	01/28/2016
DESIGNED: CL 09/15	DRAWN: PMG 09/15	DESIGN ENGINEER DATE
CHECKED: APF 09/15	CHECKED: JGJ 09/15	

INDIANA DEPARTMENT OF TRANSPORTATION
GEOMETRIC CONTROL STA 455+00 TO STA 485+00 LINE "A"

SCALE 1"=100'	BRIDGE FILE N/A	
	DESIGNATION 1297885	
SURVEY BOOK ELECTRONIC / AERIAL	DWG NO. RD-GL-09	SHEET 18 of 213
CONTRACT	PROJECT 1297885	

17-Aug-15 13:58:20  
Plotted By: JMD


pw:\pxpw\_int\aztec.us:PW\_PROD\Documents\AZE1337-01\_I69\_FD\Sheets\Roadway\DU04A\1297885-RD-S-GEO04A-18.dgn

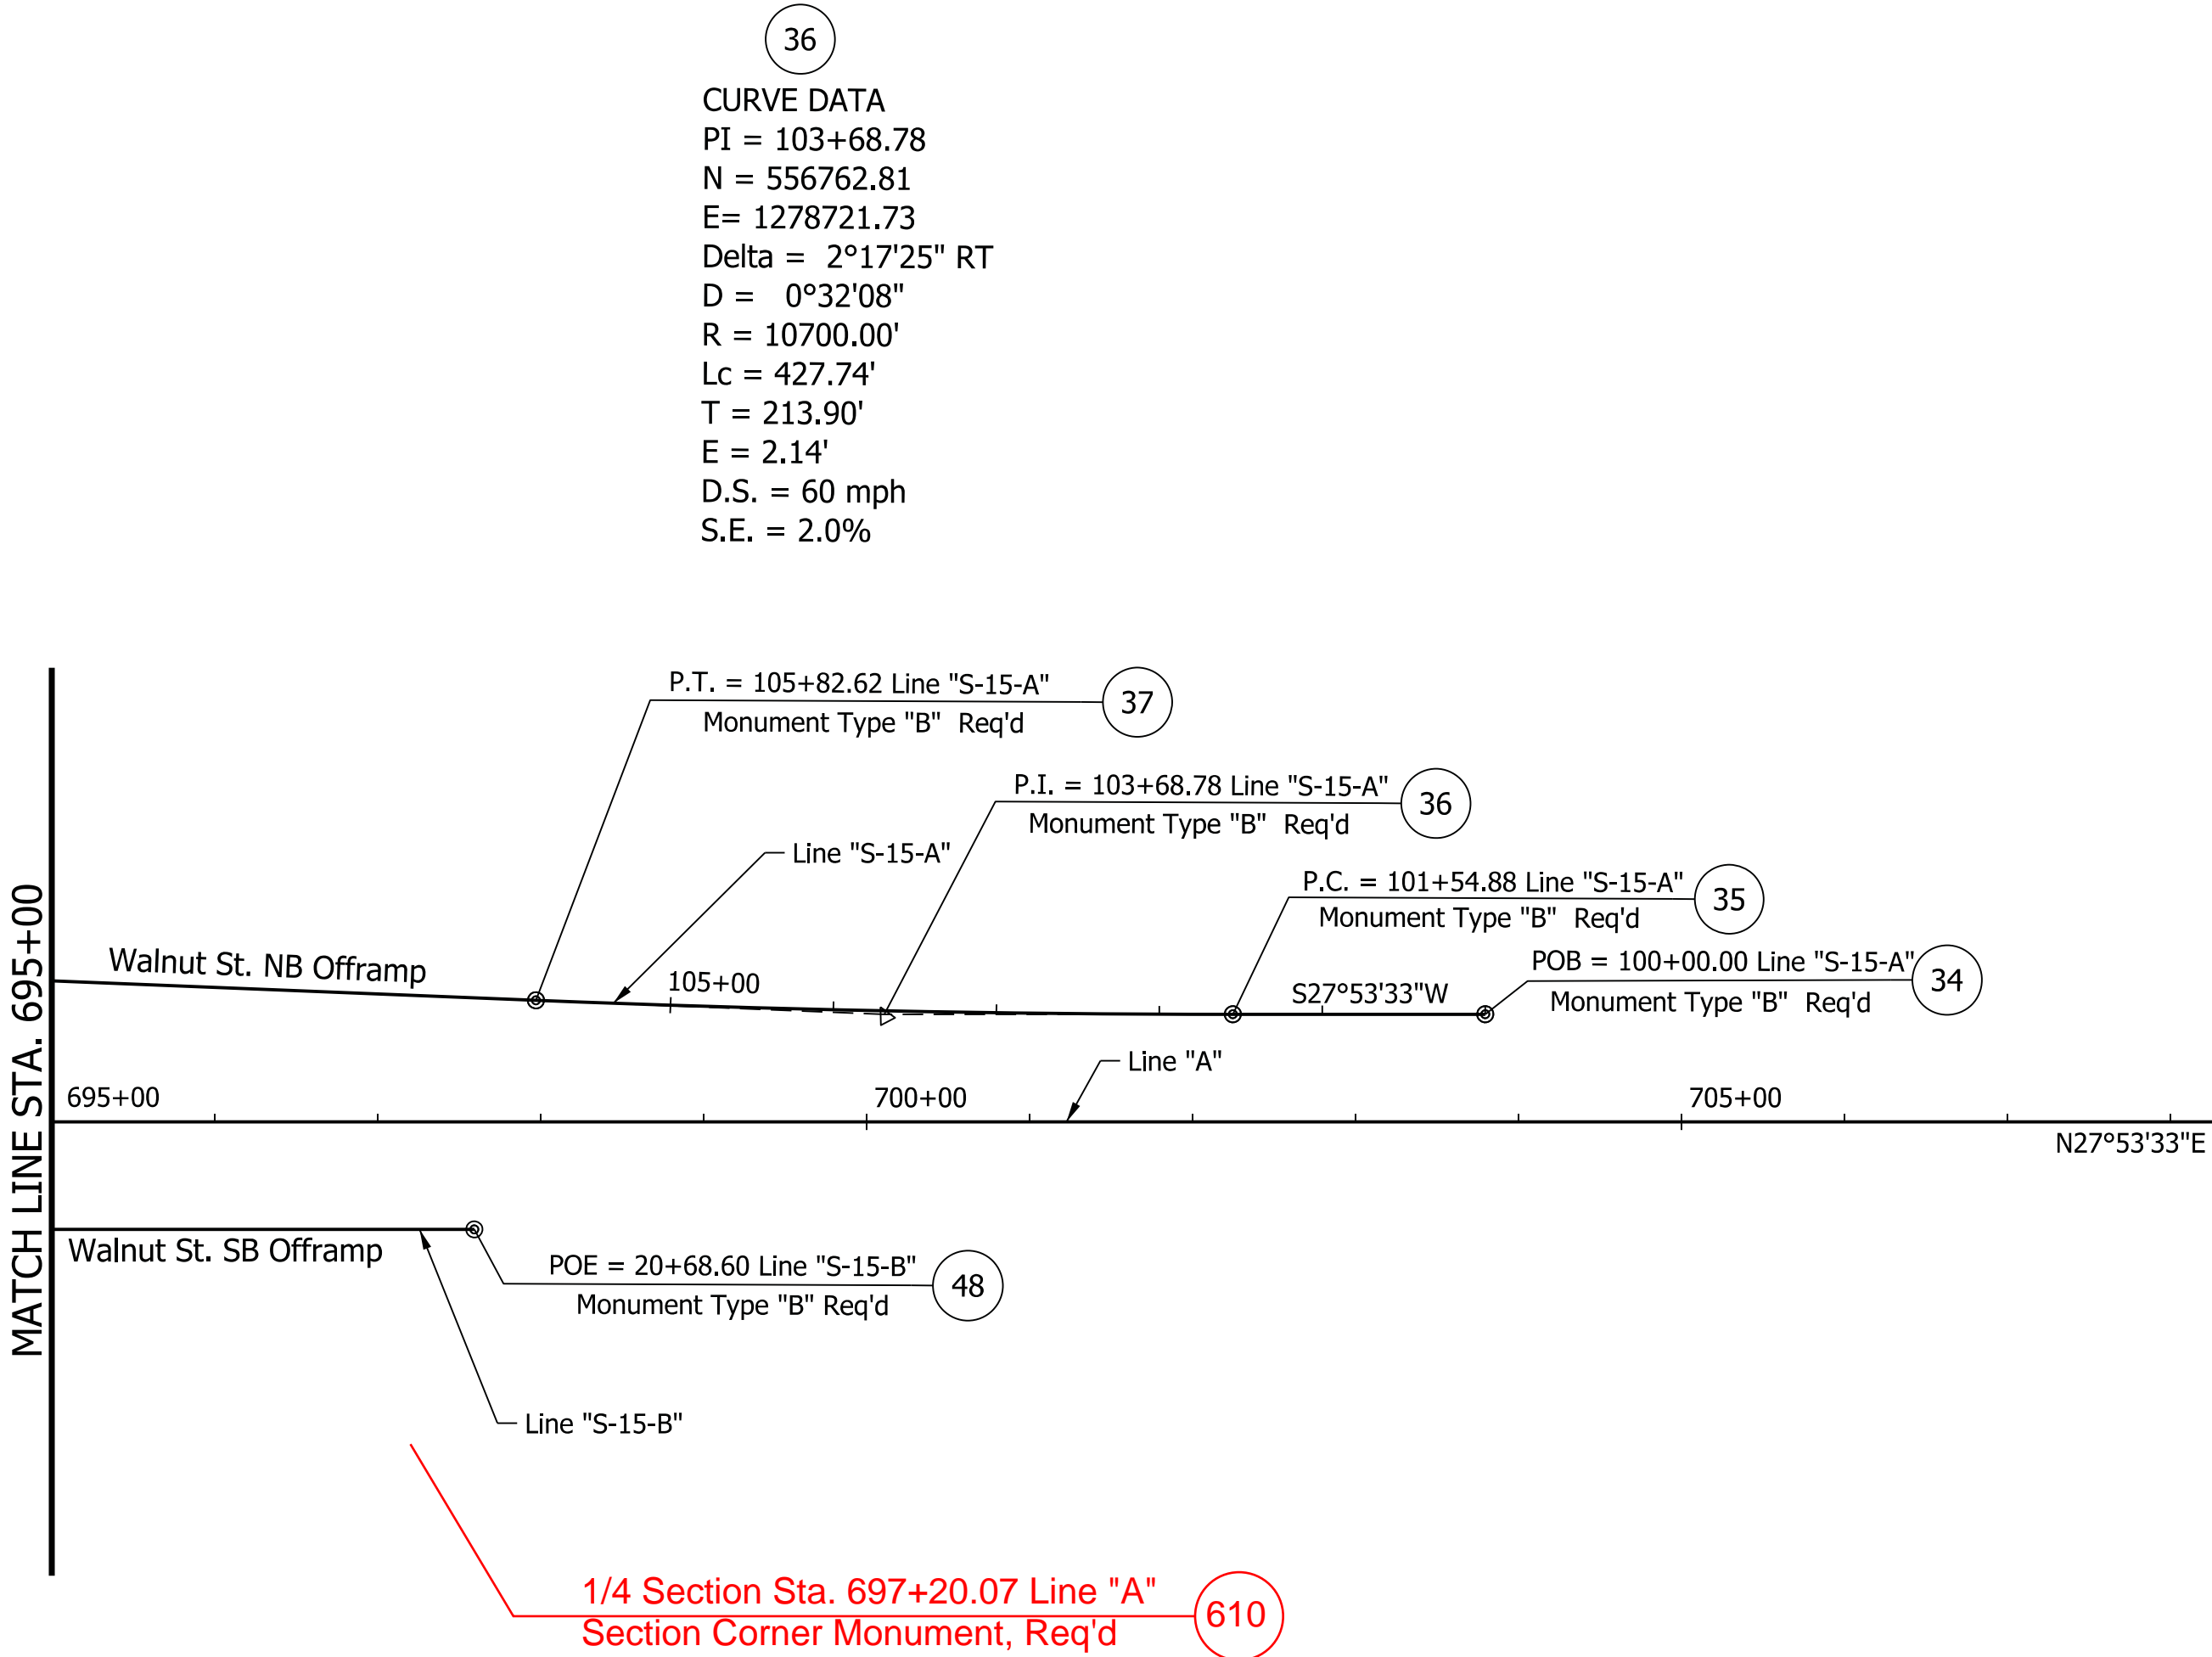

POINT	STATION	LINE	NORTHING	EASTING
34	100+00.00	S-15-A	557088.75	1278894.25
35	101+54.88	S-15-A	556951.86	1278821.80
36	103+68.78	S-15-A	556762.81	1278721.73
37	105+82.62	S-15-A	556577.91	1278614.19
48	118+33.41	S-15-B	556478.74	1278720.72
610	697+20.07	"A"	556382.012	1278819.691

Note:  
Line "A" is equivalent to Line "SR 37" indicated  
in the Location Control Route Survey Plat,  
survey book 201300365 (Des. No. 1297885).



DATE	REVISION

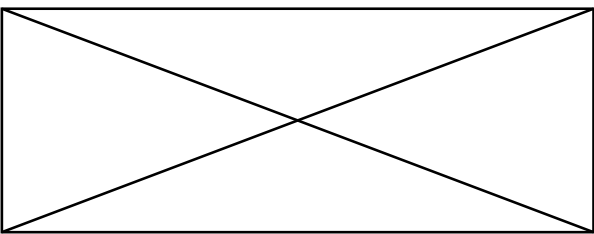

RECOMMENDED FOR APPROVAL	<i>Jeff Callcott</i>	02/23/2016
DESIGNED: CLL	07/15	DRAWN: PMG 07/15
CHECKED: APF	07/15	CHECKED: JGJ 07/15

INDIANA DEPARTMENT OF TRANSPORTATION
GEOMETRIC CONTROL STA 695+00 to STA 725+00 LINE "A"

SCALE	BRIDGE FILE	
1"=100'		
	DESIGNATION	
	1297885	
SURVEY BOOK	DWG NO.	SHEET
	RD-GL-18	19 of 210
CONTRACT	PROJECT	
	1297885	

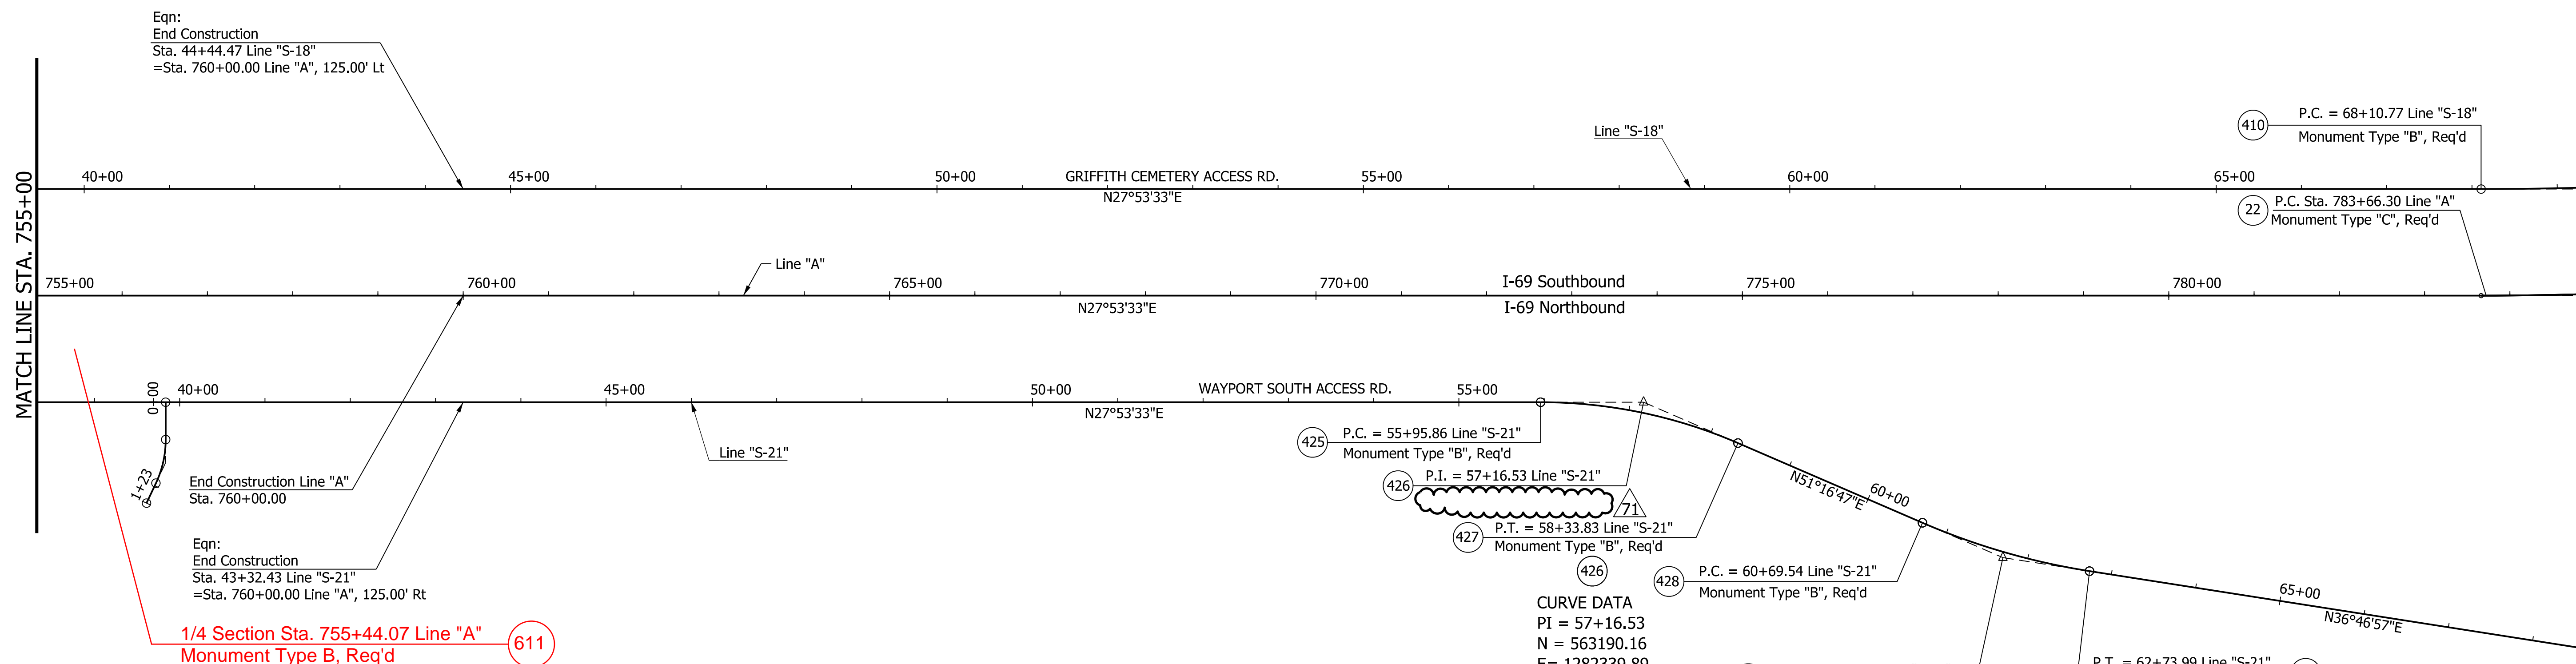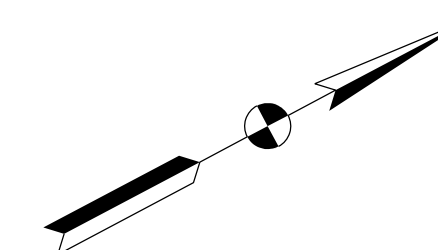

POINT	STATION	LINE	NORTHING	EASTING
22	783+66.30	A	564116.7370	1282688.9018
410	68+10.77	S-18	564175.2144	1282578.4234
425	55+95.86	S-21	563083.5184	1282283.4410
426	57+16.53	S-21	563190.1648	1282339.8898
427	58+33.83	S-21	563265.6429	1282434.0332
428	60+69.54	S-21	563413.0869	1282617.9394
429	61+72.31	S-21	563477.3714	1282698.1211
430	62+73.99	S-21	563559.6811	1282759.6575
611	755+44.07	"A"	561592.682	1281424.49


Notes:

- 1- Line "A" is equivalent to Line "SR 37" indicated in the Location Control Route Survey Plat, survey book 201300365 (Des. No. 1297885).
- 2- Line "S-18" Sta. 10+00.00 is equivalent to Sta. 1+75.00 of Line "PR-S-Griffith Access-1" as shown in the right-of-way plans.

DATE	REVISION
07/25/2018	△△ FDC 804 - Level 1 Remove PI Monuments From Monroe Co Roads

Engineer's Professional Stamp and Seal shall apply only to the portions of plans, specifications, surveys, reports, or other documents specifically identified or described below. Engineer shall not be responsible for any other associated documents.

Revision Number 71

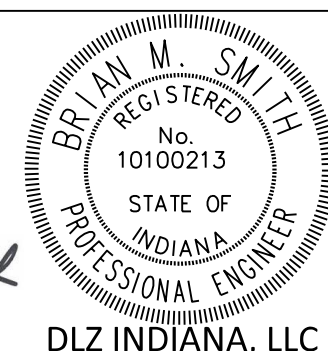RECOMMENDED  
FOR APPROVAL

DESIGNED:

CHECKED:


Items not specifically changed are still applicable under the signed and sealed original contract plans and any prior interim plan changes.

DATE \_\_\_\_\_

INDIANA  
DEPARTMENT OF TRANSPORTATION

GEOMETRIC CONTROL  
STA 755+00 to STA 760+00 LINE "A"

SCALE	BRIDGE FILE	
1"=100'		
	DESIGNATION	
	1297885	
SURVEY BOOK	DWG NO.	SHEET
	RD-GL-20	21A of 210
CONTRACT	PROJECT	
	1297885	

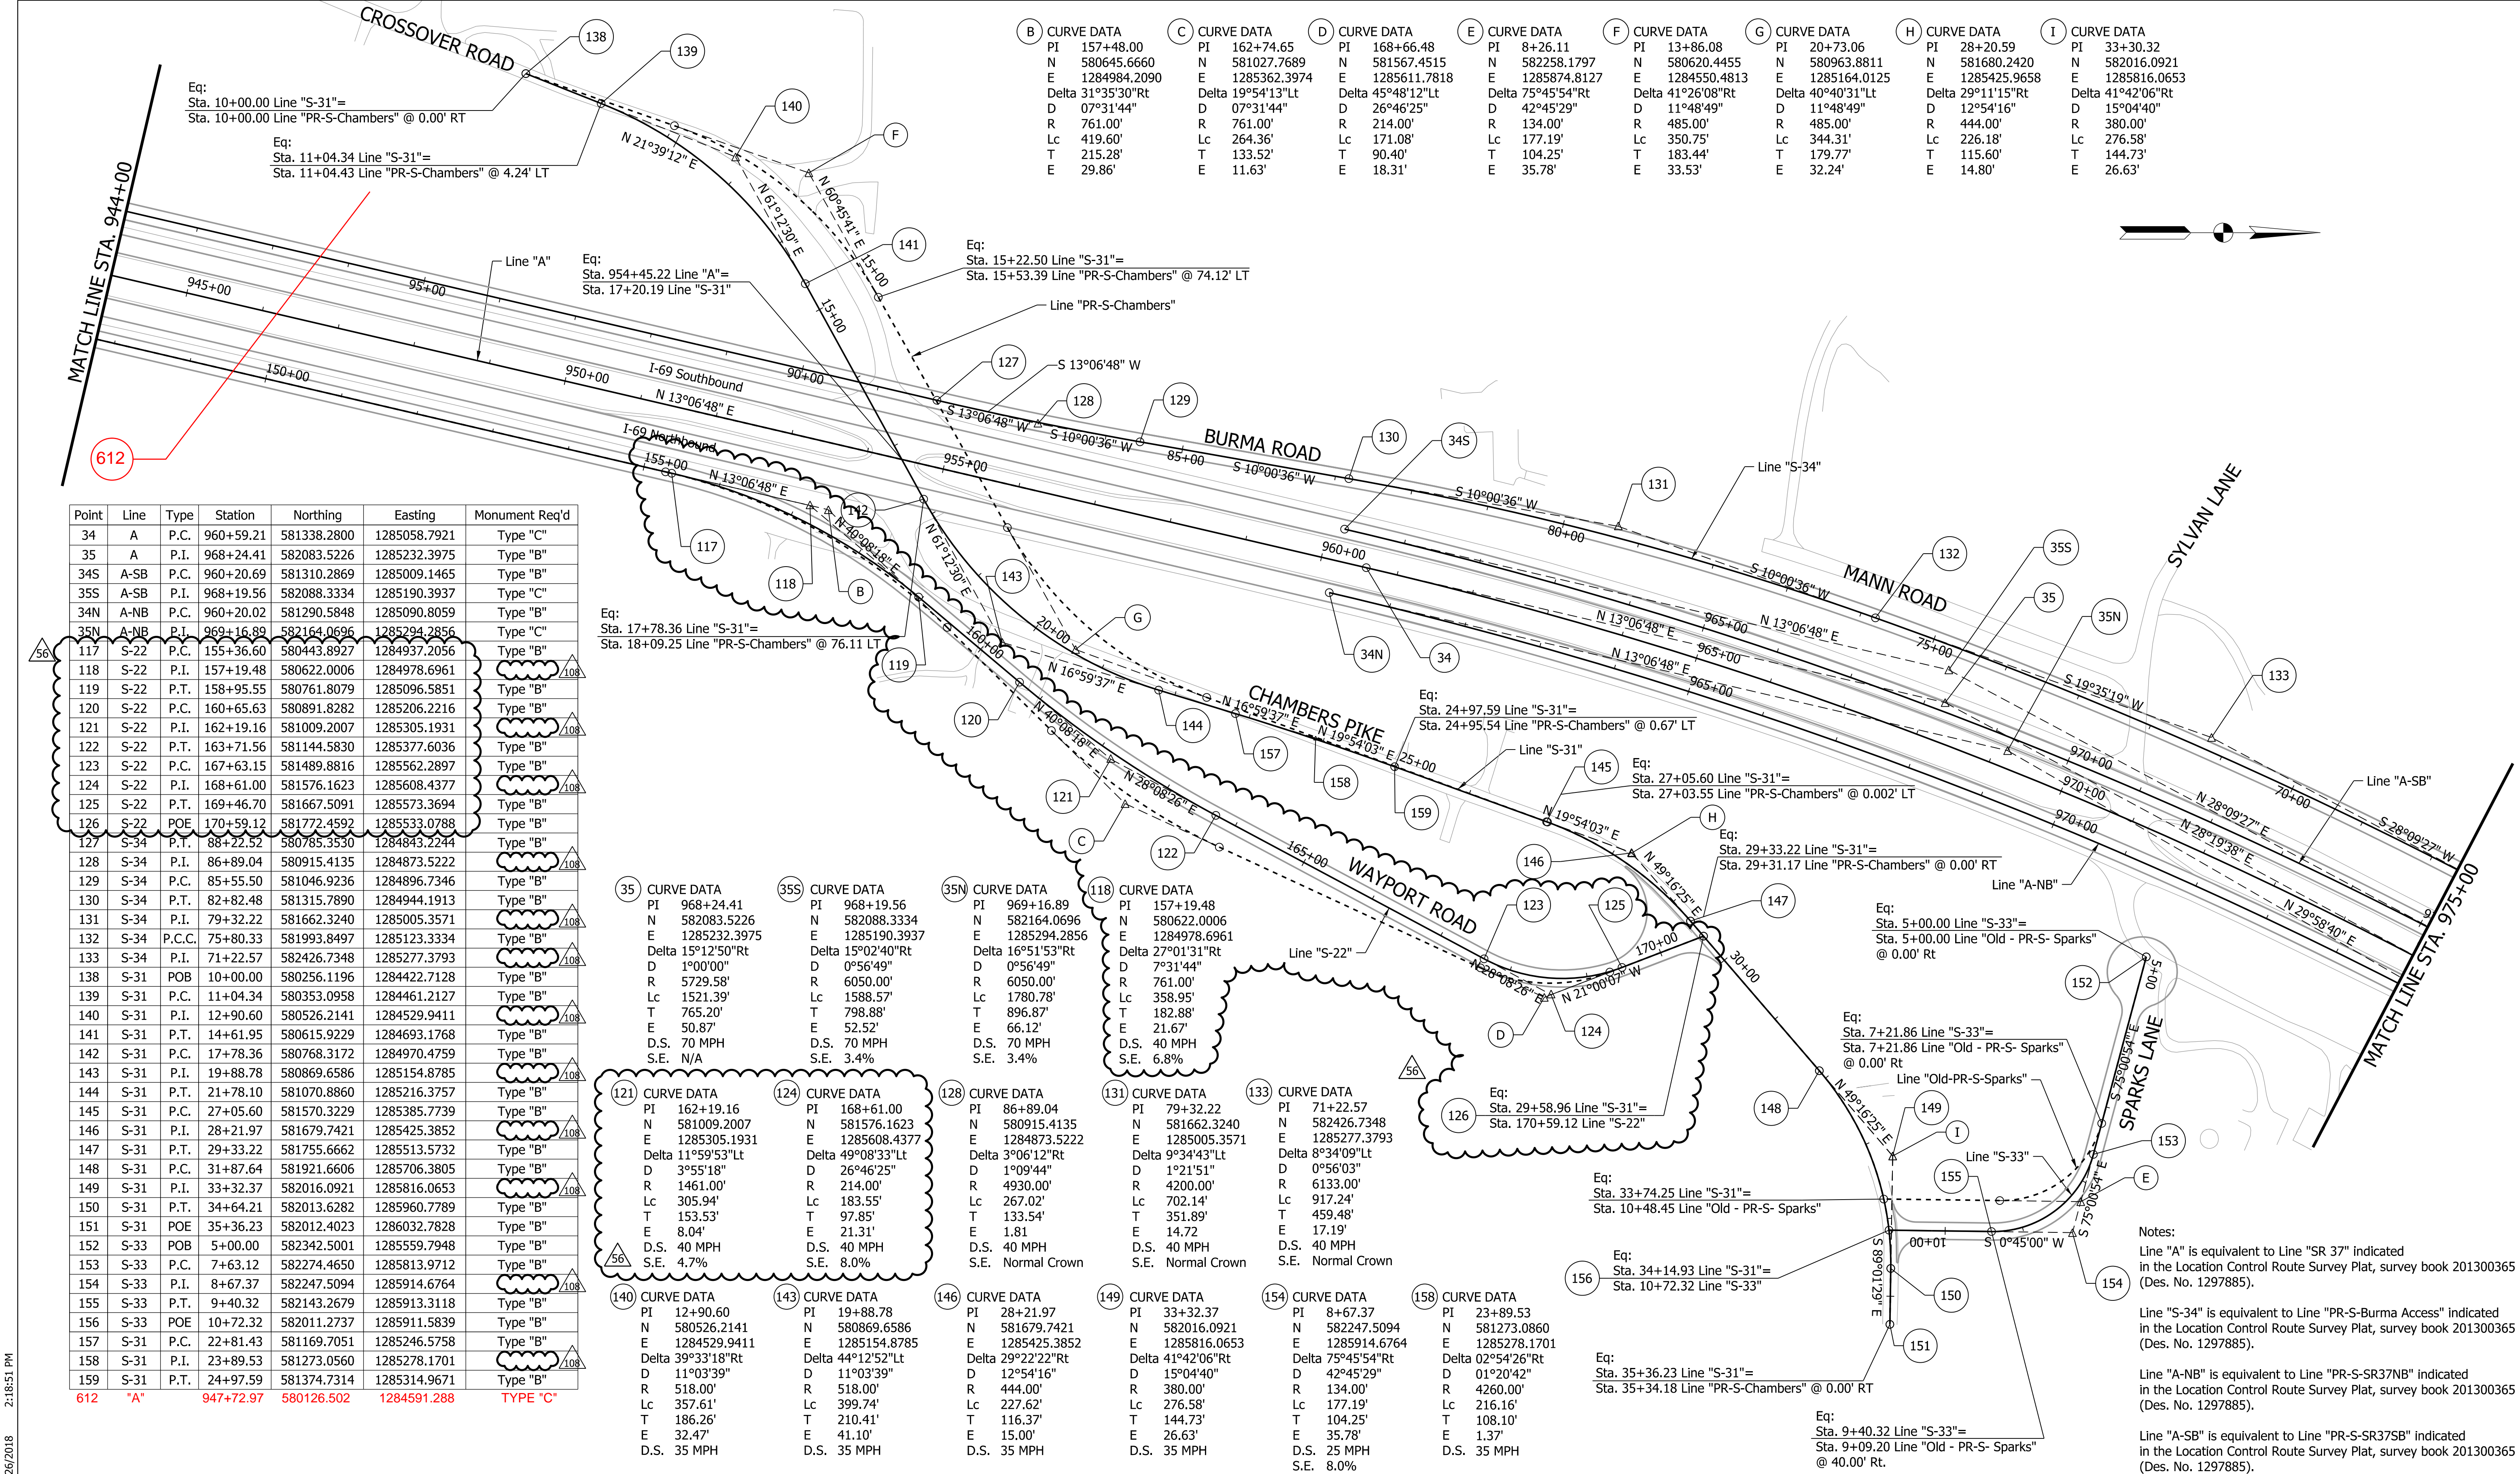

DATE	REVISION
12/21/2017	FDC 498 - Level 2 Wayport Road Redesign
07/25/2018	FDC 804 - Level 1 Remove PI Monuments from Monroe Co Roads

Engineer's Professional Stamp and Seal shall apply only to the portions of plans, specifications, surveys, reports, or other documents specifically identified or described below. Engineer shall not be responsible for any other associated documents.

Revision Number 108

BRITANN M. SMITH  
REGISTERED  
No. 10100213  
STATE OF INDIANA  
PROFESSIONAL ENGINEER

8/13/2018

DLZ INDIANA, LLC

RECOMMENDED FOR APPROVAL: \_\_\_\_\_ DATE: \_\_\_\_\_

DESIGNED: \_\_\_\_\_

CHECKED: \_\_\_\_\_

Items not specifically changed are still applicable under the signed and sealed original contract plans and any prior interim plan changes.

INDIANA DEPARTMENT OF TRANSPORTATION			SCALE 1"=100'	BRIDGE FILE N/A
			VERTICAL SCALE NONE	DESIGNATION 1297885
GEOMETRIC CONTROL STA 944+00 TO STA 975+00 LINE "A"			SURVEY BOOK ELECTRONIC / AERIAL CONTRACT	DWG NO. RD-GL-02 PROJECT 1297885
			SHEET 24b OF 223	

Plotted By: jbakker 2:18:51 PM 7/26/2018